



Colliers International  
1850 Mount Diablo Boulevard, Suite 200  
Walnut Creek, CA 94596 | United States  
[www.colliers.com](http://www.colliers.com)

LEASING AGENT

**Scott Ellis**  
(925) 279-5575

[scott.ellis@colliers.com](mailto:scott.ellis@colliers.com)

**Matt Hurd**  
(925) 279-5567

[matt.hurd@colliers.com](mailto:matt.hurd@colliers.com)

## Olympic Plaza

1904 Olympic/1243 Alpine  
Walnut Creek, CA 94596

Second Floor

Owned and Managed by

**Cranbrook Group, Inc.**


Approximate Area Calculations  
Subject To Verification:

1,544 rsf

As-built Plan To Be Verified

This information displayed while not guaranteed has been secured by sources we believe to be reliable. This information is subject to errors & omissions. Any tenant should conduct their own investigation.

Plan Revision - 4-4-18

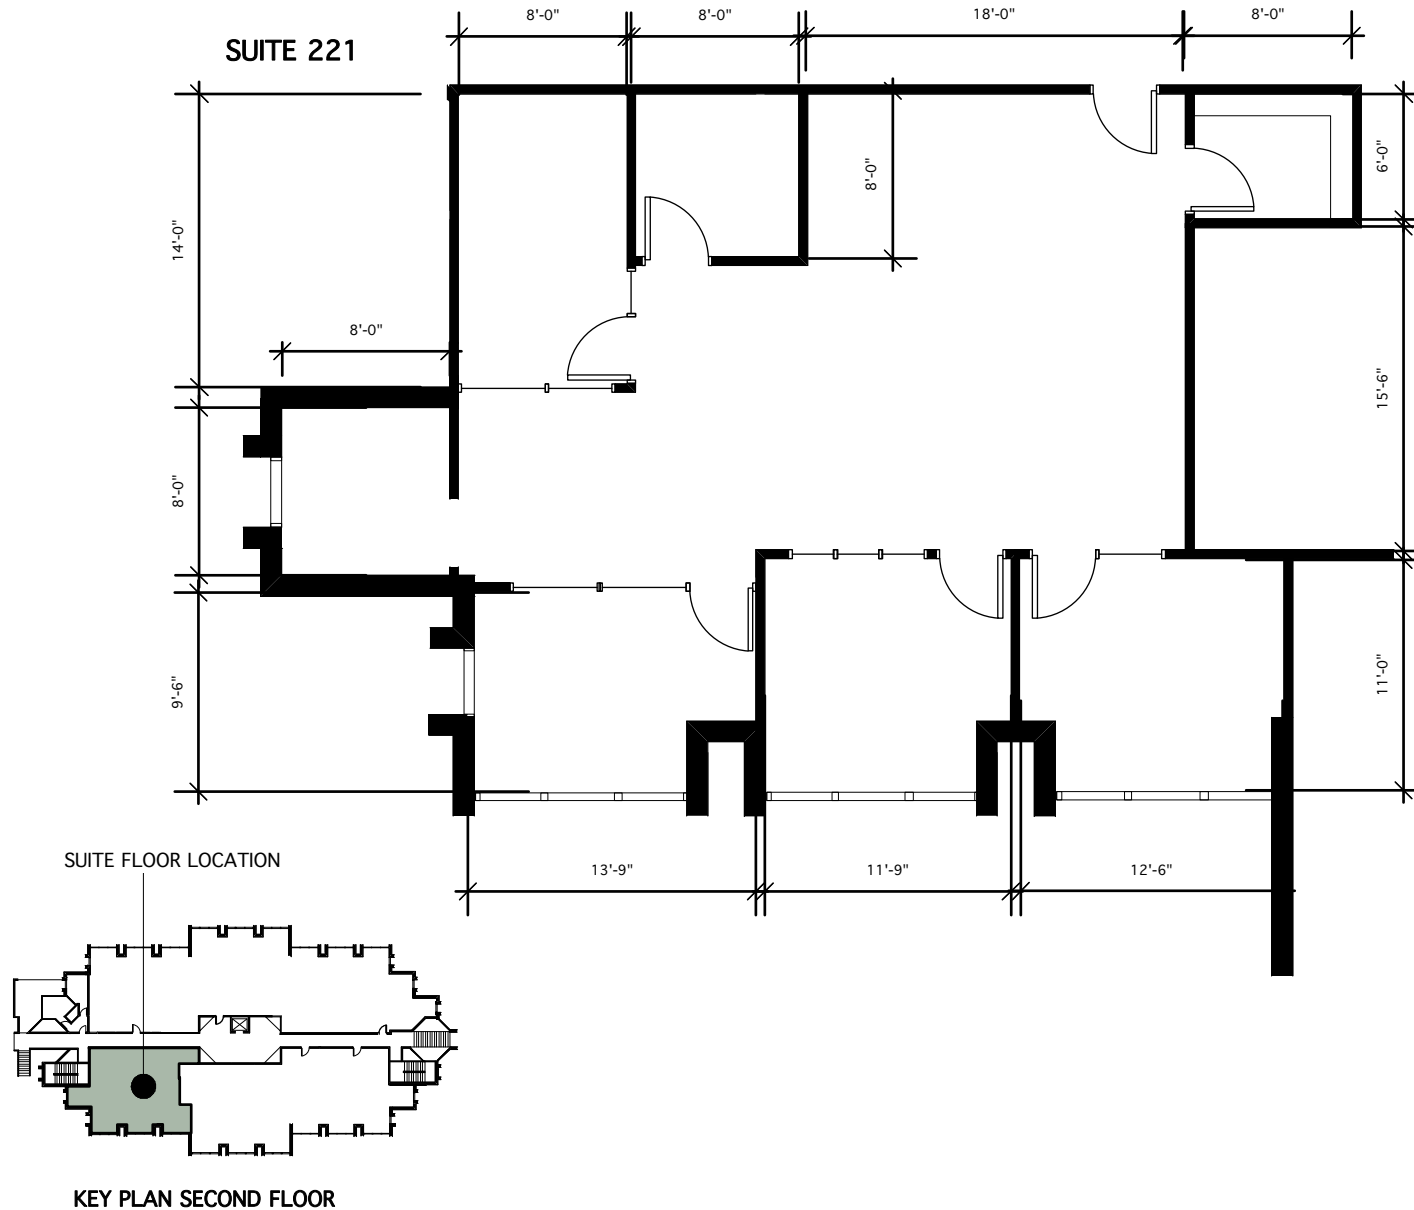

"Neither the planner nor the real estate agent warrant the accuracy of the information contained herein. Drawings are for preliminary purposes only and not to be relied upon until confirmed by the furniture vendor, contractor and the building architect in the field."