

I hereby certify that this plan, specification or report was prepared by me or under my direct supervision and that I am a duly licensed architect under the laws of the State of Minnesota.

Signature: _____
Date: 12/4/15
Project: 1300 W Lake St

CHECK SET
PRINTED
1.26.16

CONCRETE
PODIUM PERMIT
DEC 4, 2015

ORIGINAL ISSUE: 12/4/15

REVISIONS

No.	Description	Date
1	PLAN REVIEW COMMENTS	1/8/16
3	BUILDING PERMIT SET	2/29/16

215524
PROJECT NUMBER

LB, MG RL
DRAWN BY CHECKED BY

KEY PLAN



1300 W LAKE ST

FIRST LEVEL FLOOR PLAN

A1.1


GENERAL NOTES - FLOOR PLANS

- SEE STRUCTURAL FOR PT CONCRETE POUR STRIP LOCATIONS. PROVIDE TRAFFIC COATINGS AT THESE LOCATIONS PER SPECIFICATIONS.
- SEE ENLARGED UNIT PLANS FOR INTERIOR UNIT INFORMATION.
- PROVIDE ACCESS PANELS WHERE REQUIRED FOR ACCESS TO MECHANICAL AND/OR ELECTRICAL ITEMS. VERIFY WITH MECHANICAL AND ELECTRICAL AND COORDINATE EACH LOCATION WITH ARCHITECT IF LOCATED IN FINISHED SPACES.
- SEE SHEETS A10.1 AND A10.2 FOR WALL TYPES.

DIMENSIONING STANDARDS

- AT MASONRY AND MASONRY VENEER WALLS, DIMENSIONS ARE TO FACE OF MASONRY.
- AT NON-MASONRY OR NON-MASONRY VENEER EXTERIOR WALLS (I.E. METAL PANEL / FIBER CEMENT), WALL DIMENSIONS ARE TO EXTERIOR FACE OF SHEATHING.
- SHAFT WALL DIMENSIONS ARE TO FACE OF 6"PSBM BOARD.
- AT INTERIOR SINGLE STUD OR DOUBLE STUD WALLS, DIMENSIONS ARE TO CENTERLINE OF WALL ASSEMBLY.
- AT INTERIOR FURRING WALLS, DIMENSIONS ARE TO FACE OF 6"PSBM BOARD.

ALL DIMENSIONS FOLLOW THESE STANDARDS UNLESS NOTED OTHERWISE.

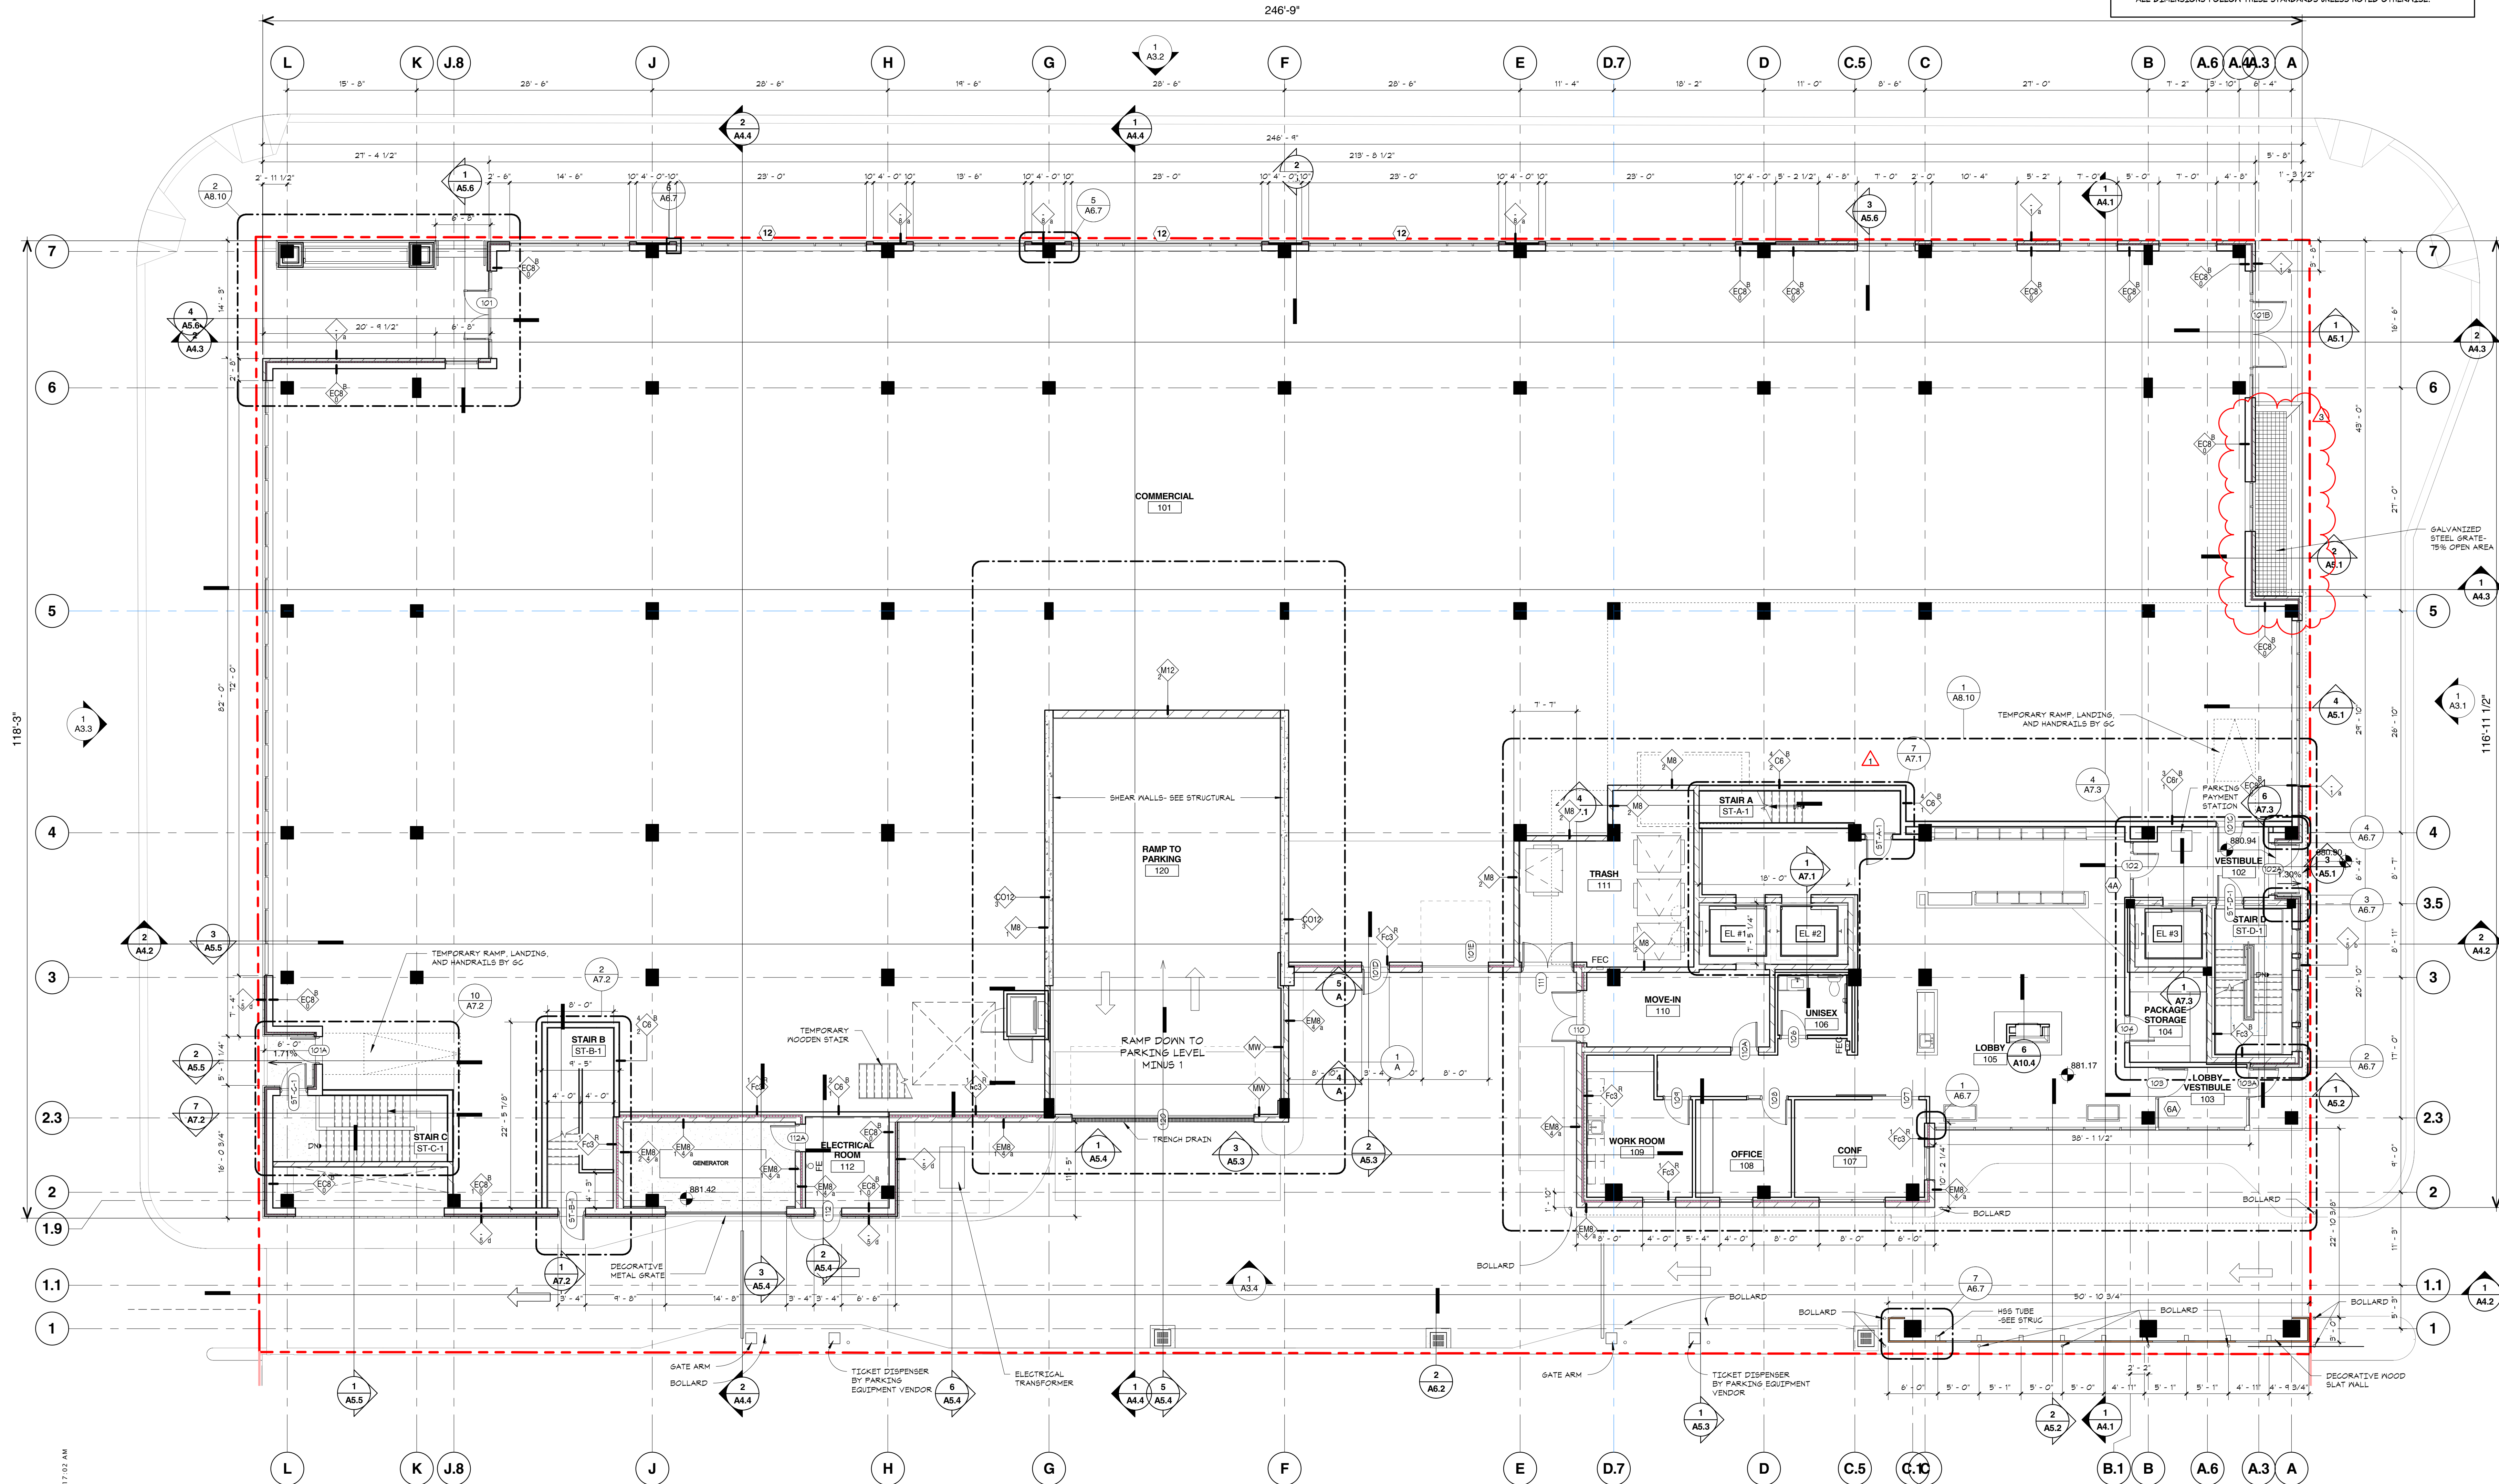

1 FIRST LEVEL FLOOR PLAN

A1.1 1/8" = 1'-0"