



SUITE 420

SUITE FLOOR LOCATION

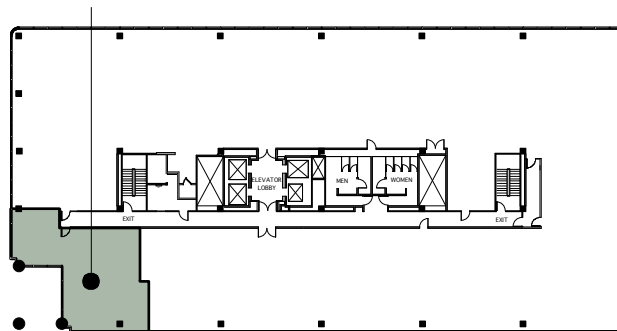

FOURTH FLOOR KEY PLAN

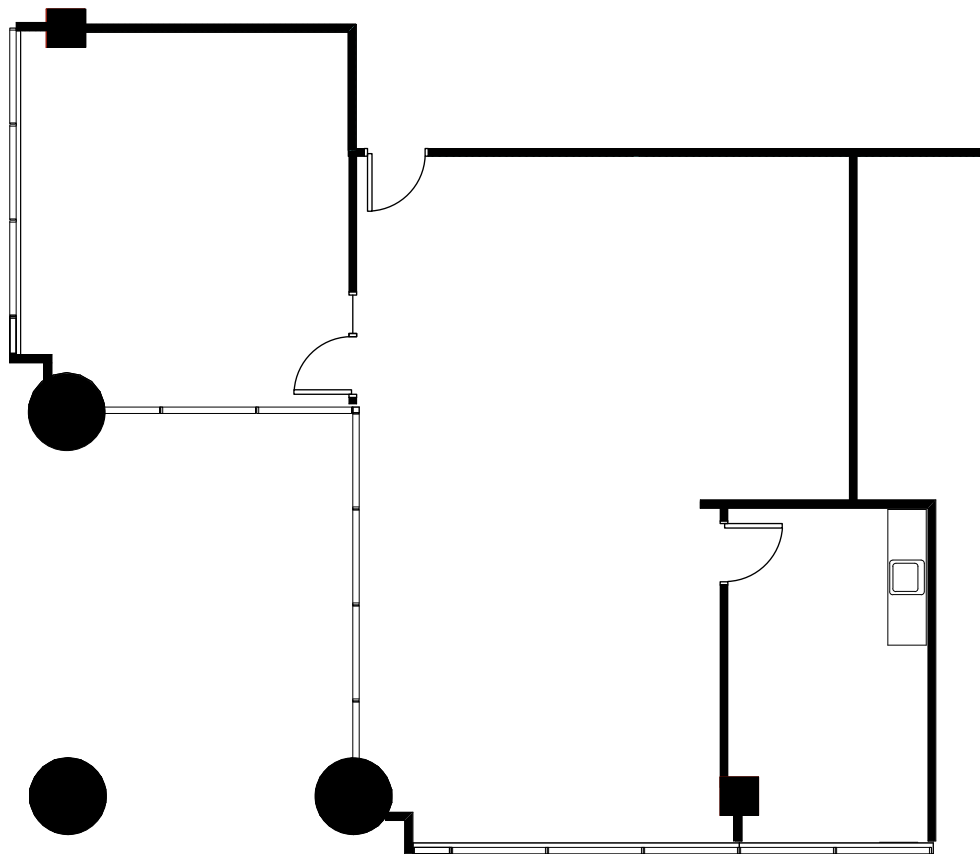

CONCORD BLVD.



Colliers International
1850 Mount Diablo Boulevard, Suite 200
Walnut Creek, CA 94596 | United States
www.colliers.com

LEASING AGENT

Scott Ellis
(925) 279-5575

scott.ellis@colliers.com

Eric Erickson
(925) 279-5580

eric.erickson@colliers.com

Sutter Square

1800 Sutter Street
Concord, CA 94520

Fourth Floor

Proudly Owned By:

MERIDIAN
Buildings for Life

Approximate Area Calculations
Subject To Verification:

1,639 rsf

As-built Plan To Be Verified

This information displayed while not guaranteed has been secured by sources we believe to be reliable. This information is subject to errors & omissions. Any tenant should conduct their own investigation.

Plan Revision - 2-18-18