



SUITE 250

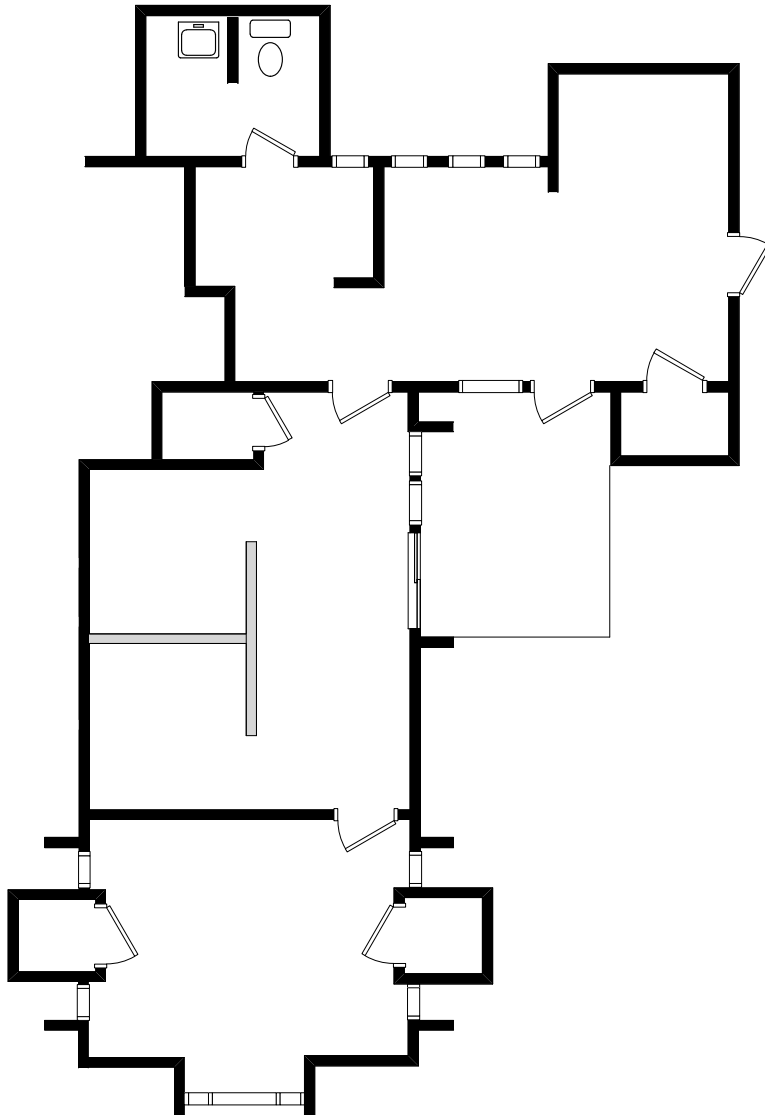


LOCATION BUILDING 35

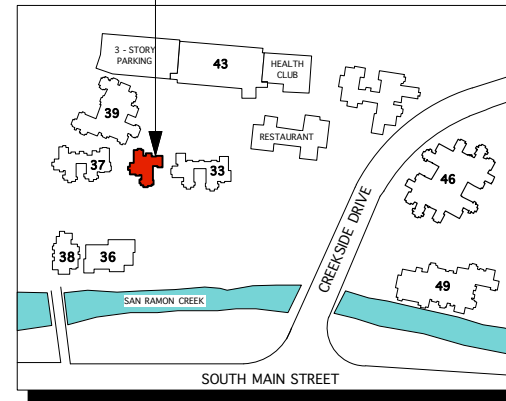

BUILDING KEY PLAN



SUITE FLOOR LOCATION

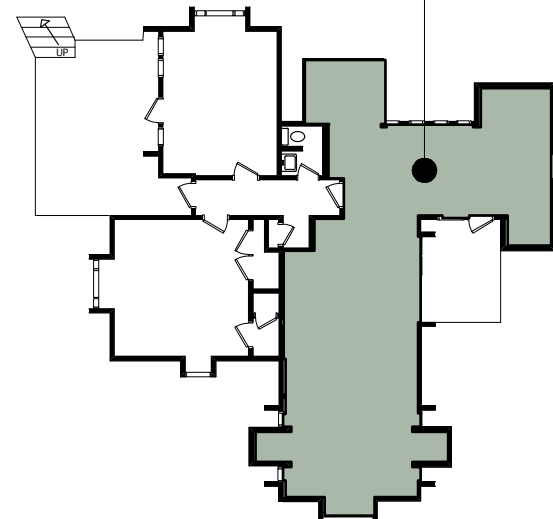

SECOND FLOOR KEY PLAN

Colliers
INTERNATIONAL

Colliers International
1850 Mount Diablo Boulevard, Suite 200
Walnut Creek, CA 94596 | United States
www.colliers.com

LEASING AGENT

ERIC ERICKSON
(925) 279-5580

PETER GUTZWILLER
(925) 279-4604

QUAIL COURT OFFICE PARK

WALNUT CREEK, CA

Owned and Managed by:

WESTLAKE
DEVELOPMENT
COMPANY, INC.

APPROXIMATE AREA CALCULATIONS
SUBJECT TO VERIFICATION:

808 RSF

AS-BUILT PLAN
TO BE VERIFIED

THIS INFORMATION DISPLAYED WHILE NOT GUARANTEED HAS BEEN
SECURED BY SOURCES WE BELIEVE TO BE RELIABLE. THIS
INFORMATION IS SUBJECT TO ERRORS & OMISSIONS. ANY TENANT
SHOULD CONDUCT THEIR OWN INVESTIGATION.