



SUITE 300

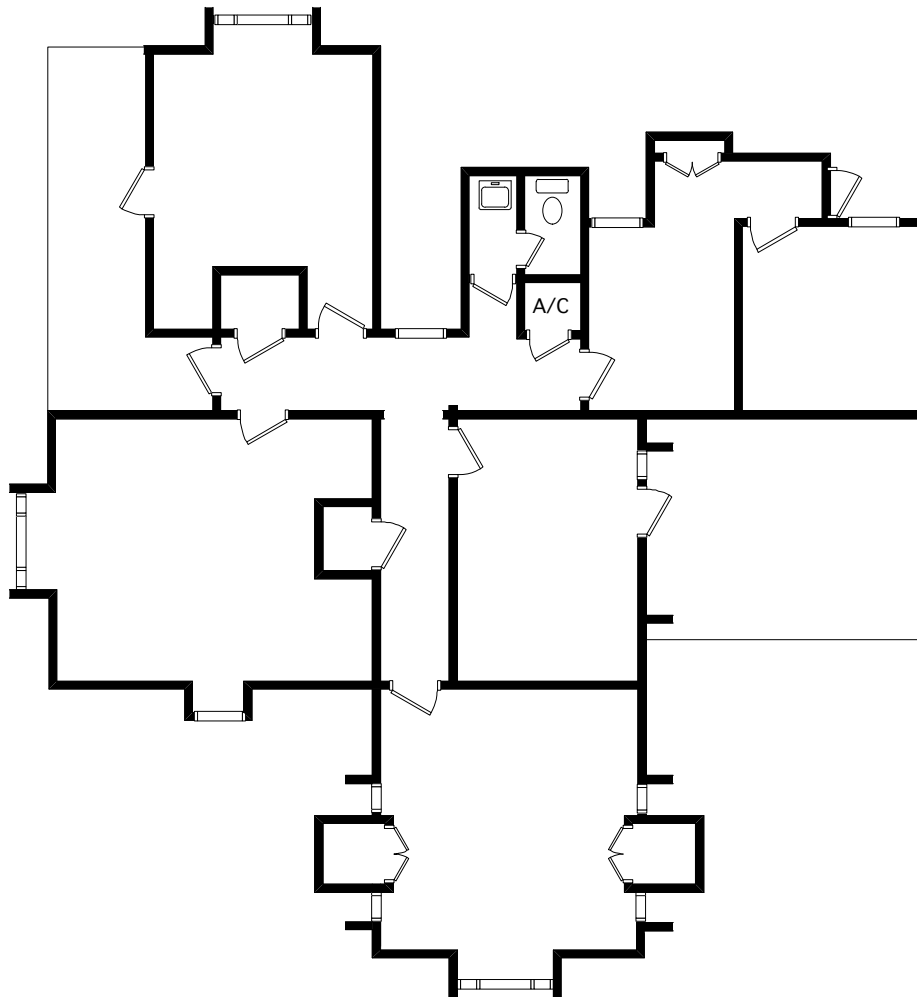


LOCATION BUILDING 37

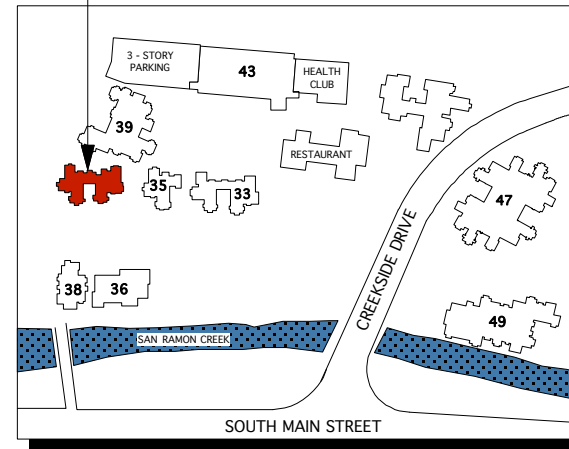

BUILDING KEY PLAN

SUITE FLOOR LOCATION

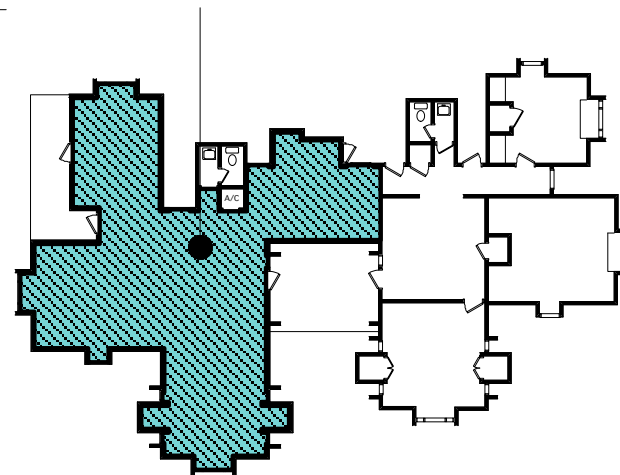

3RD FLOOR KEY PLAN

Leased by



1850 MT. DIABLO BLVD
SUITE 200
WALNUT CREEK, CA
94596

VOICE: (925) 279-0120
FAX: (925) 279-0450

ERIC ERICKSON
(925) 279-5580

PETER GUTZWILLER
(925) 279-4604

QUAIL COURT OFFICE PARK

WALNUT CREEK, CA

Owned and Managed by:

WESTLAKE
DEVELOPMENT
COMPANY, INC.

APPROXIMATE AREA
CALCULATIONS
SUBJECT TO VERIFICATION:

1,147 RSF

**AS-BUILT PLAN
TO BE VERIFIED**

THIS INFORMATION DISPLAYED WHILE NOT
GUARANTEED HAS BEEN SECURED BY SOURCES
WE BELIEVE TO BE RELIABLE. THIS INFORMATION
IS SUBJECT TO ERRORS & OMISSIONS. ANY
TENANT SHOULD CONDUCT THEIR OWN
INVESTIGATION.

PLAN - A 10/20/09