


FOR LEASE > SUITE B 180 > 1,563 RSF

Brookstone


2025 N. 3RD STREET, PHOENIX, AZ



SPEC

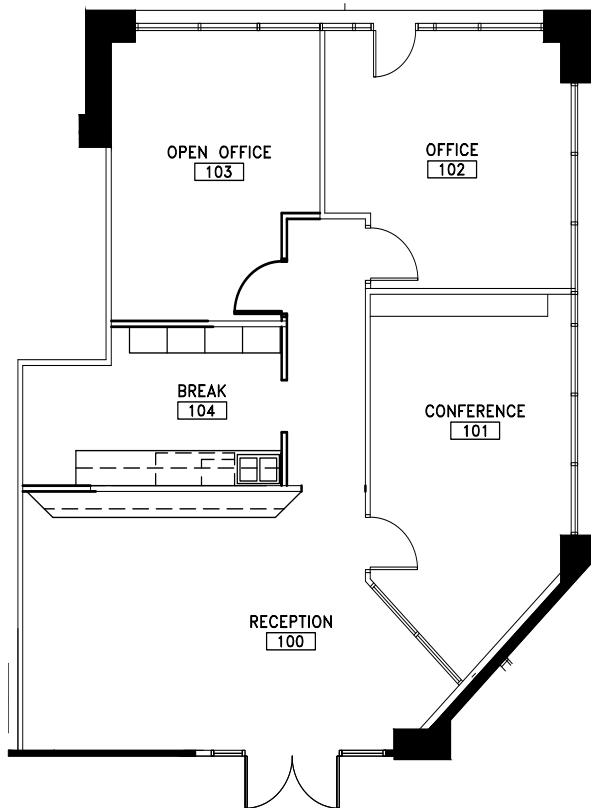

AS-BUILT

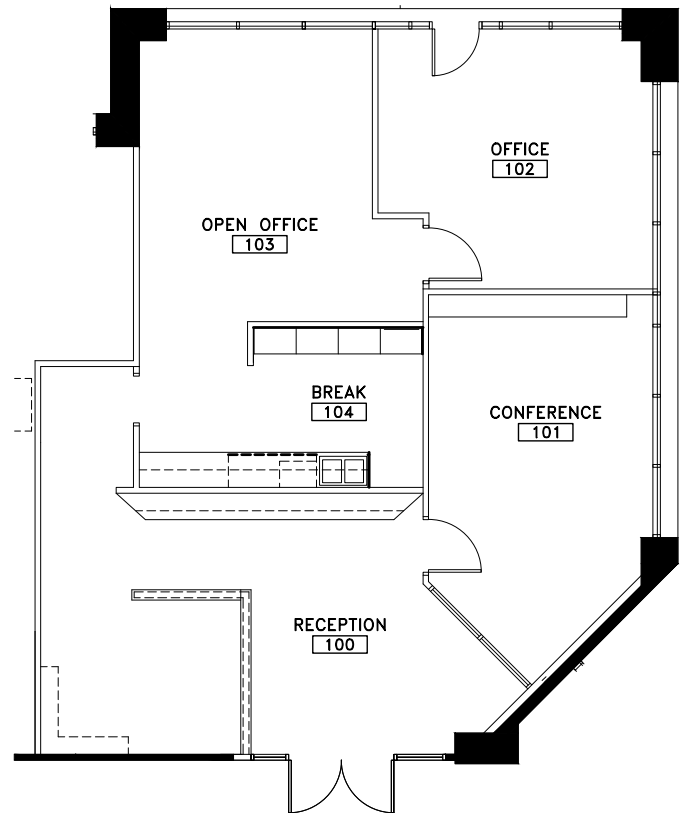

LINDSEY CARLSON
602 222 5084
lindsey.carlson@colliers.com

This document/email has been prepared by Colliers International for advertising and general information only. Colliers International makes no guarantees, representations or warranties of any kind, expressed or implied, regarding the information including, but not limited to, warranties of content, accuracy and reliability. Any interested party should undertake their own inquiries as to the accuracy of the information. Colliers International excludes unequivocally all inferred or implied terms, conditions and warranties arising out of this document and excludes all liability for loss and damages arising there from. This publication is the copyrighted property of Colliers International and /or its licensor(s). © 2019 All rights reserved.

COLLIERS INTERNATIONAL
2390 E. Camelback Road, Suite 100
Phoenix, AZ 85016
www.colliers.com/greaterphoenix