



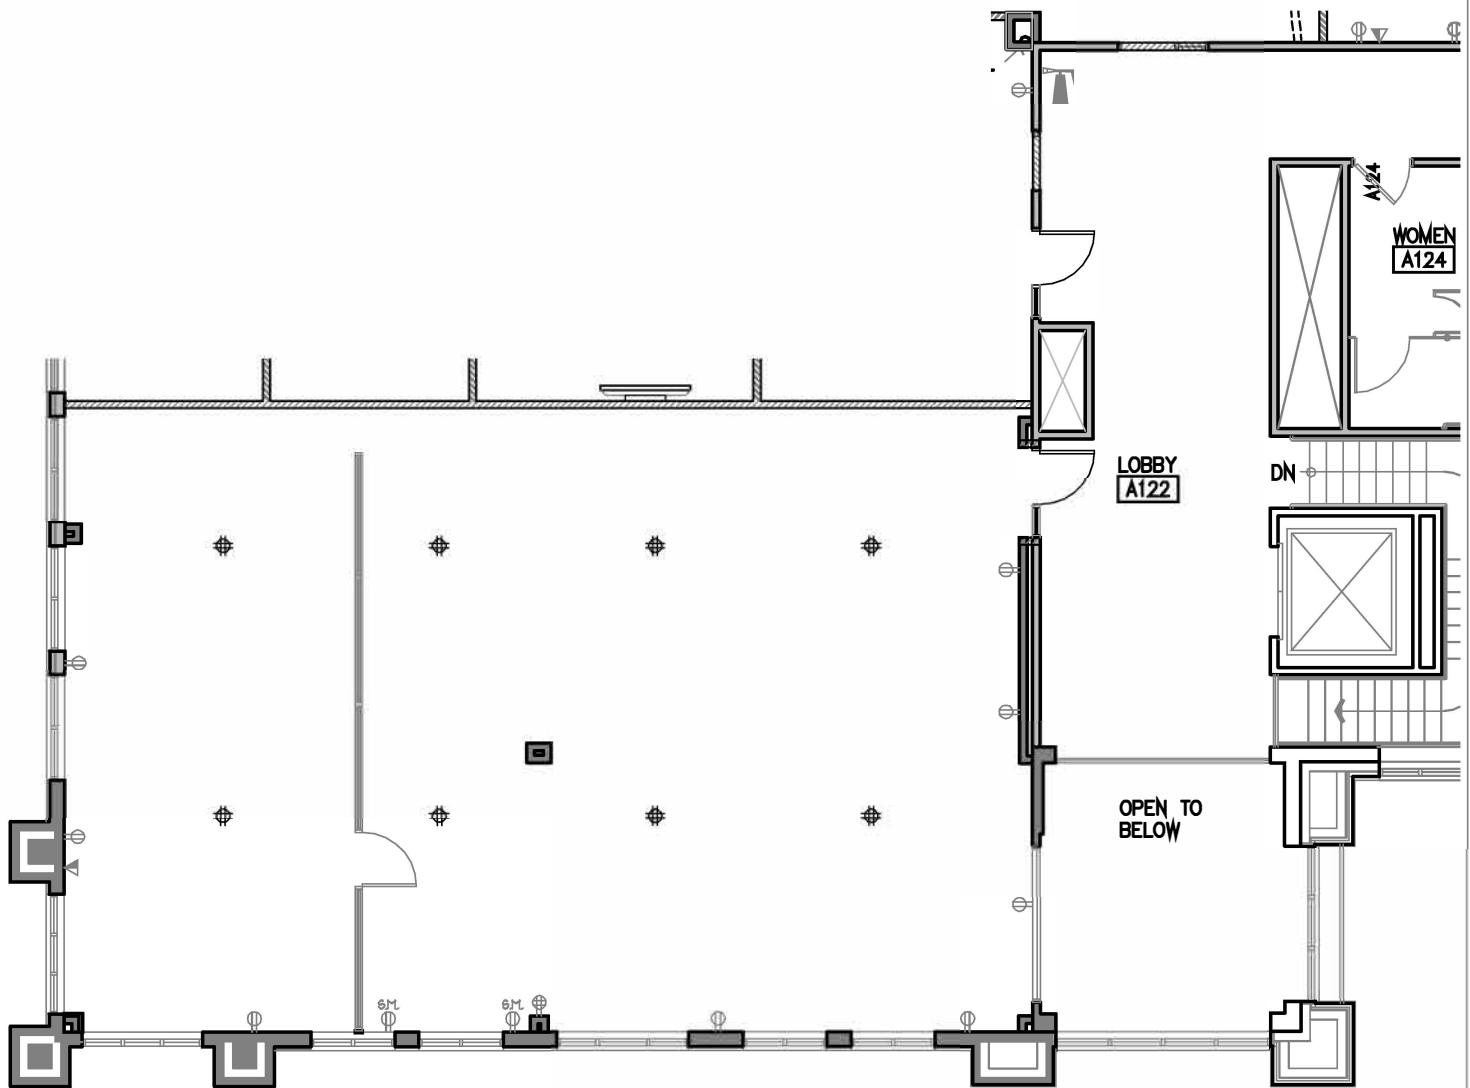

1 BLDG A-1: AS-BUILT FLOOR PLAN for: STE. 270
2xx SCALE: 3/32" = 1'-0" Note: Circles on the Plan Indicate existing electrical floor outlets.

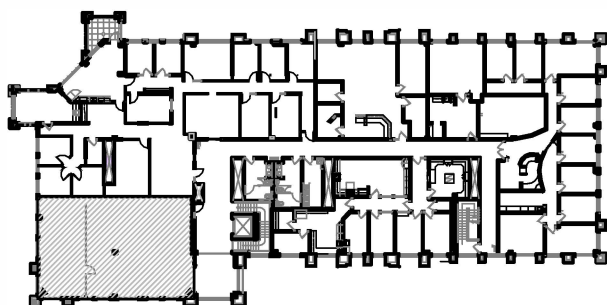

BUILDING KEY - SECOND FLOOR



OWNED and
MANAGED by



WELSH
ARCHITECTURE

4350 Baker Road, Suite 400
Minnetonka, MN 55434
952.897.7874 Fax: 952.897.7740

THE DRAWINGS AND / OR
SPECIFICATIONS CONTAINED
HEREIN ARE THE EXCLUSIVE
PROPERTY OF GENESIS
ARCHITECTURE AND SHALL
NOT BE UTILIZED OR COPIED
BY OTHER PARTIES WITHOUT
PRIOR WRITTEN CONSENT.

AS-BUILT CONDITIONS

SUITE. 270: 2262 RSF
THE FOUNTAINS @ A. LAKES
11671 FOUNTAINS DR.
MAPLE GROVE, MN 55369

SCALE: 3/32" = 1'-0"
JOB: 2017.091.0
REVISION: DATE

DRAWN BY: TGW
DATE: 12 APR '17

2xx