



LOCATION  
BUILDING 33

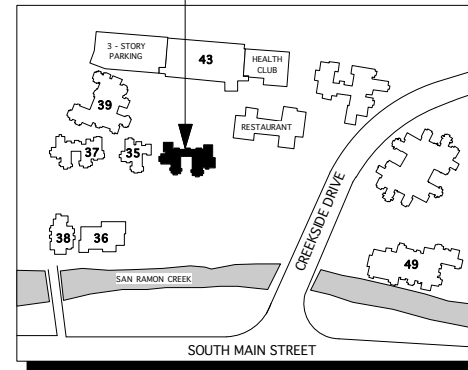


**BUILDING KEY PLAN**

**SUITE 350  
FLOOR  
LOCATION**

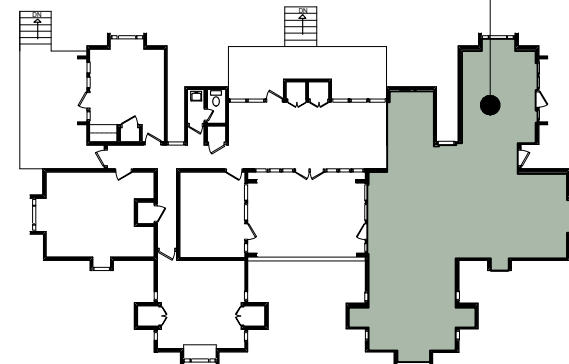

**KEY PLAN - FLOOR 3**

Leased by

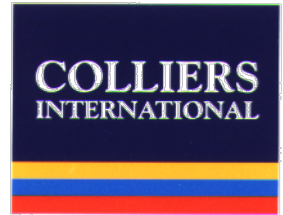

1850 MT. DIABLO BLVD  
SUITE 200  
WALNUT CREEK, CA 94596

VOICE: (925) 279-0120  
FAX: (925) 279-0450

**ERIC ERICKSON**  
(925) 279-5580

**PETER GUTZWILLER**  
(925) 279-4604

## QUAIL COURT OFFICE PARK

WALNUT CREEK, CA

Owned and Managed by:

WESTLAKE  
DEVELOPMENT  
COMPANY, INC.

APPROXIMATE AREA CALCULATIONS  
SUBJECT TO VERIFICATION:

980 RSF

**AS-BUILT PLAN**  
TO BE VERIFIED

THIS INFORMATION DISPLAYED WHILE NOT GUARANTEED  
HAS BEEN SECURED BY SOURCES WE BELIEVE TO BE  
RELIABLE. THIS INFORMATION IS SUBJECT TO ERRORS &  
OMISSIONS. ANY TENANT SHOULD CONDUCT THEIR OWN  
INVESTIGATION.