


KEY PLAN

AS-BUILT FLOOR PLAN

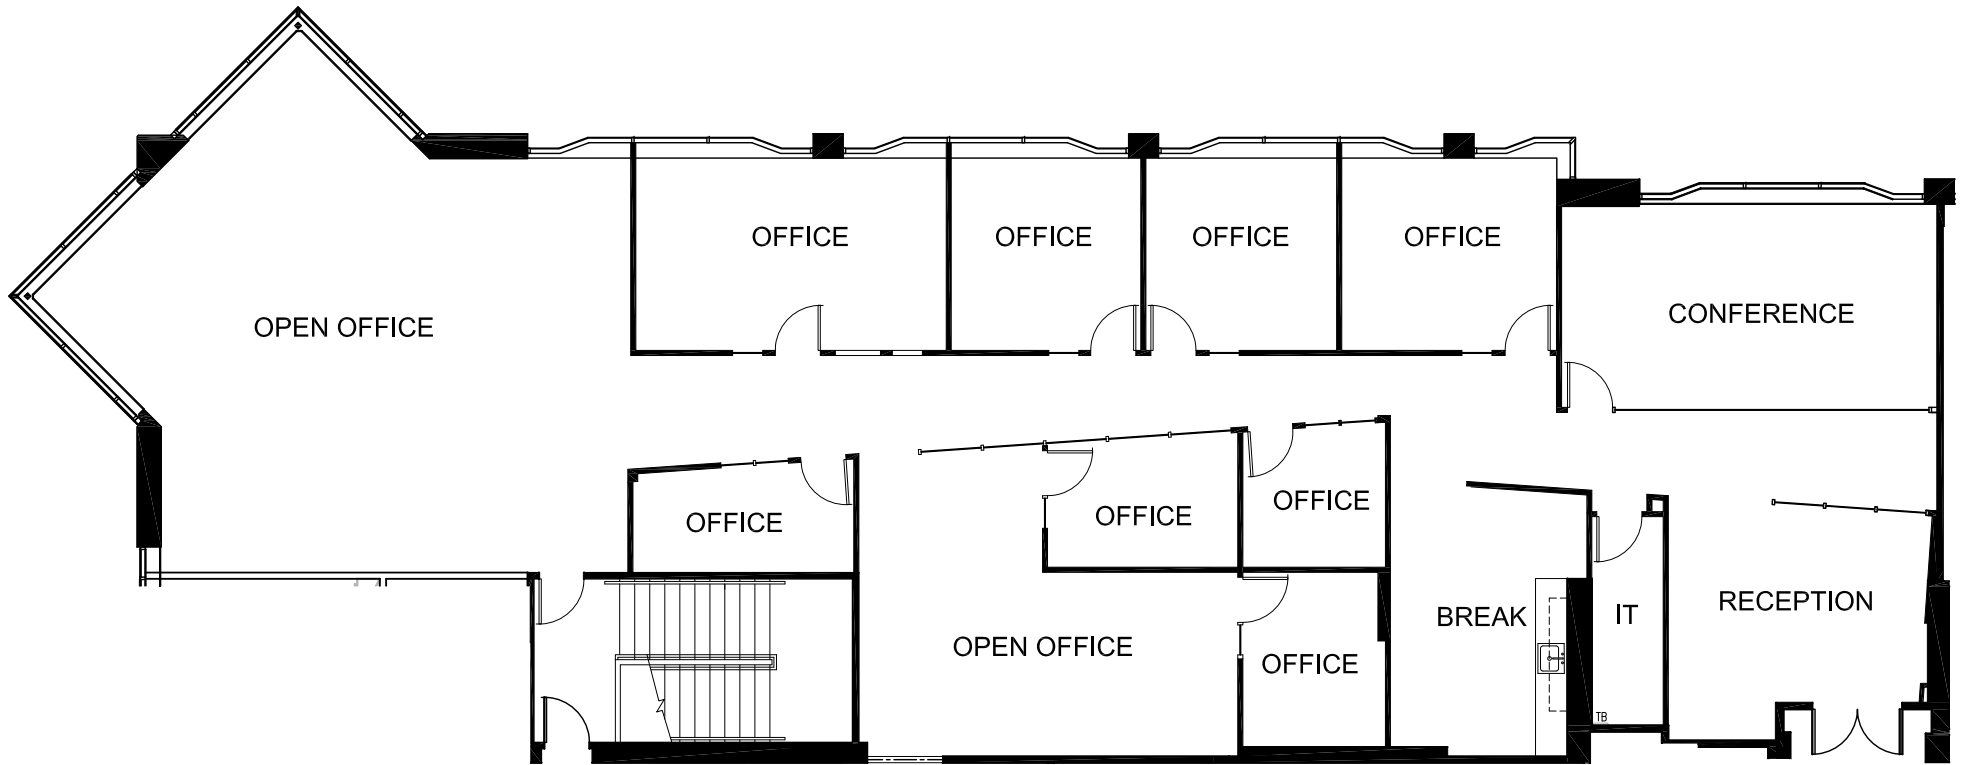

6700 Koll Center Parkway, Suite 110
 Pleasanton, CA 94566
 Tel: 925.484.5245 / Fax: 925.484.5206
www.idarchitecture.com

7031 KOLL CENTER PARKWAY, SUITE 210
 PLEASANTON, CA
 SCALE: N.T.S.
 12-12-16