



Colliers International
1850 Mount Diablo Boulevard, Suite 200
Walnut Creek, CA 94596 | United States
www.colliers.com

LEASING AGENT

Scott Ellis
(925) 279-5575

scott.ellis@colliers.com

Eric Erickson
(925) 279-5580

eric.erickson@colliers.com

Sutter Square

1800 Sutter Street
Concord, CA 94520

Second Floor

Proudly Owned By:

MERIDIAN
Buildings for Life

Approximate Area Calculations
Subject To Verification:

2,751 rsf

As-built Plan To Be Verified


This information displayed while not guaranteed has been secured by sources we believe to be reliable. This information is subject to errors & omissions. Any tenant should conduct their own investigation.

Plan Revision - 3-12-18

MIRA VISTA TERRACE

AVAILABLE SUITE LOCATION

KEY PLAN - FLOOR 2

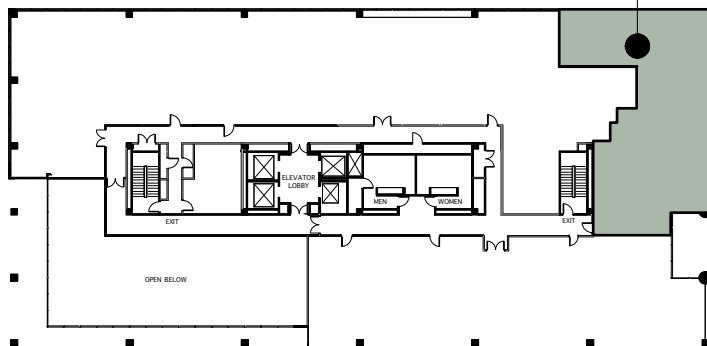

SUITE 220