



Colliers International
1850 Mount Diablo Boulevard, Suite 200
Walnut Creek, CA 94596 | United States
www.colliers.com

LEASING AGENT

Matt Hurd
(925) 279-5567

matt.hurd@colliers.com

Scott Ellis
(925) 279-5575

scott.ellis@colliers.com

590 YGNACIO VALLEY ROAD
WALNUT CREEK, CA

First Floor

Owned and Managed by:

590 YVR Associates LLC.


Approximate Area Calculations
Subject To Verification:

5,225 rsf


As-built Plan To Be Verified

This information displayed while not guaranteed has been secured by sources we believe to be reliable. This information is subject to errors & omissions. Any tenant should conduct their own investigation.

Plan Revision - 3-13-18

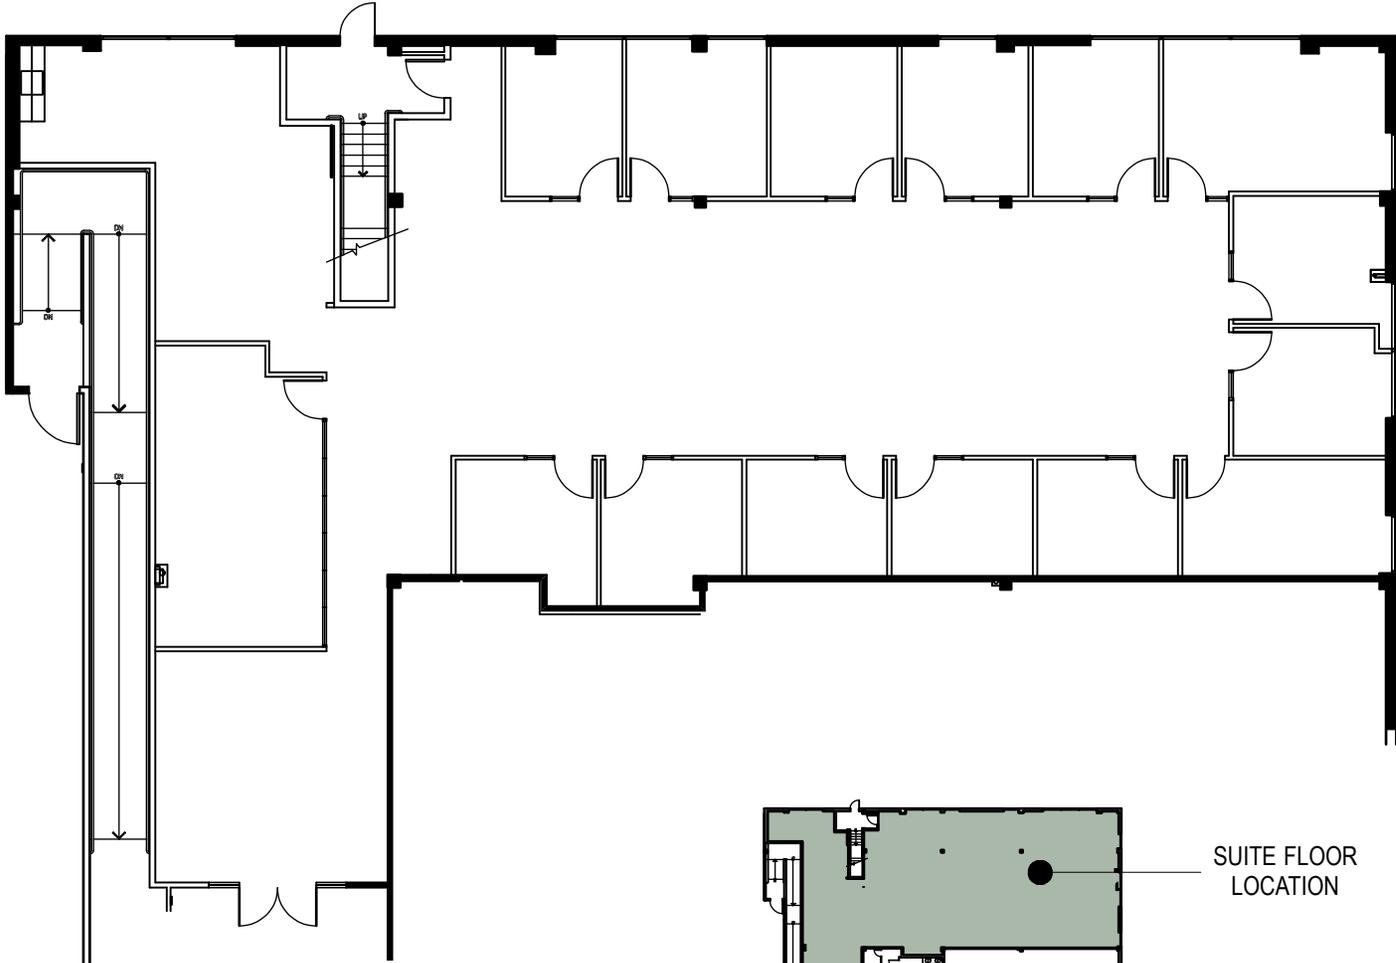

SUITE 103

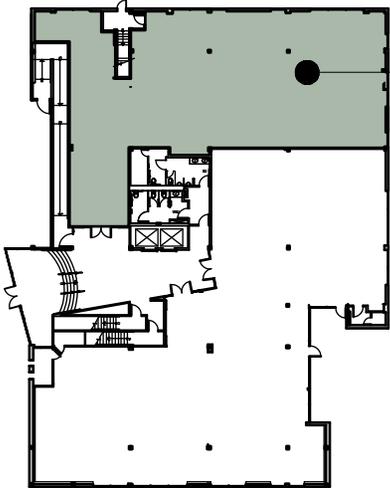

KEY PLAN FLOOR - 1