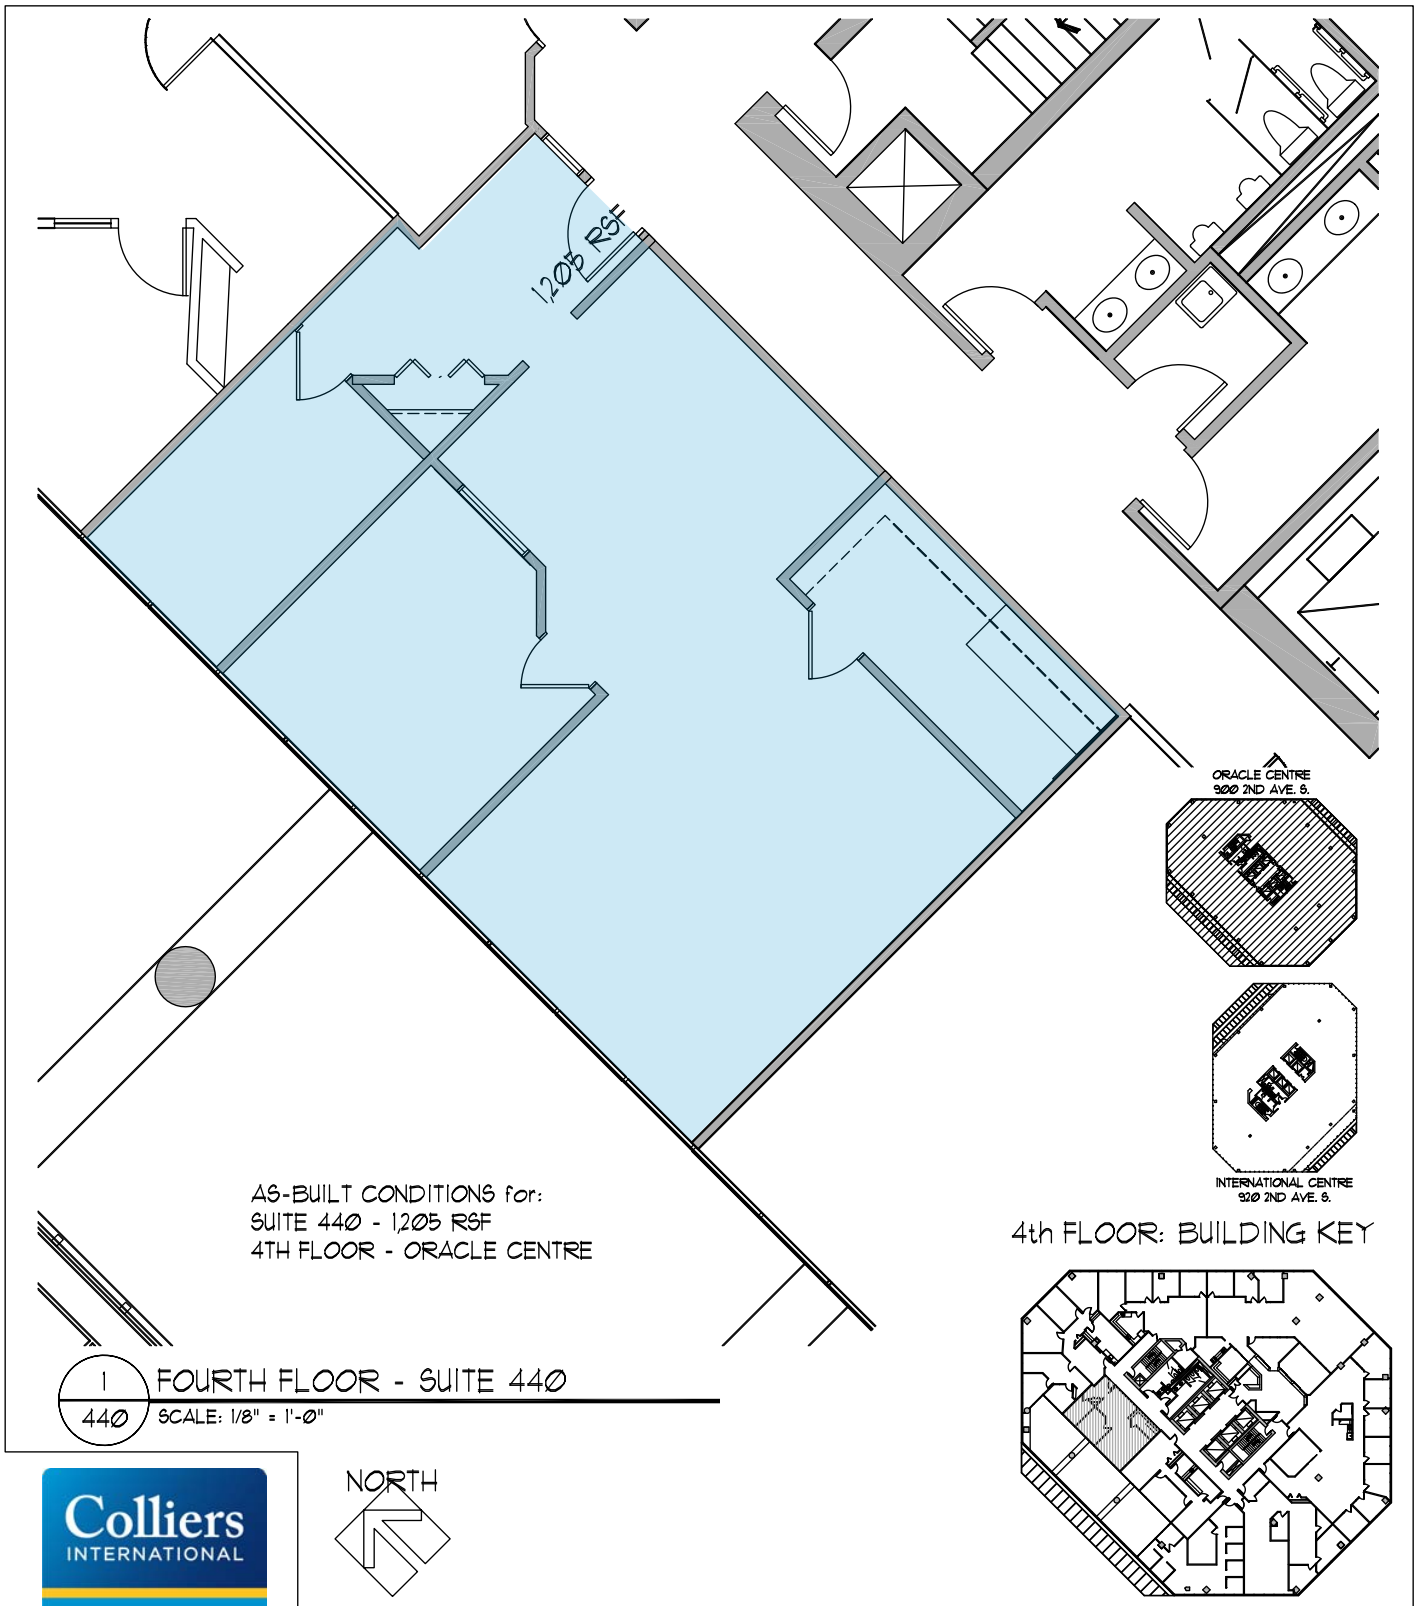


4350 Baker Road ~ Suite 400
Minnetonka, MN 55343
952.897.7874 Fax: 952.897.7740

AS-BUILT FOR:

ORACLE CENTRE
FLOOR 4 - SUITE 440 - AREA: 1205 RSF
900 SECOND AVE. SOUTH
MINNEAPOLIS, MN 55402-3314

SCALE: 1/8" = 1'-0"
JOB: 2012.029.0
REVISION: DATE

DRAWN BY: TGW
DATE: 14 JAN. '14

FLOOR NO.: (4) OF (19)

440