


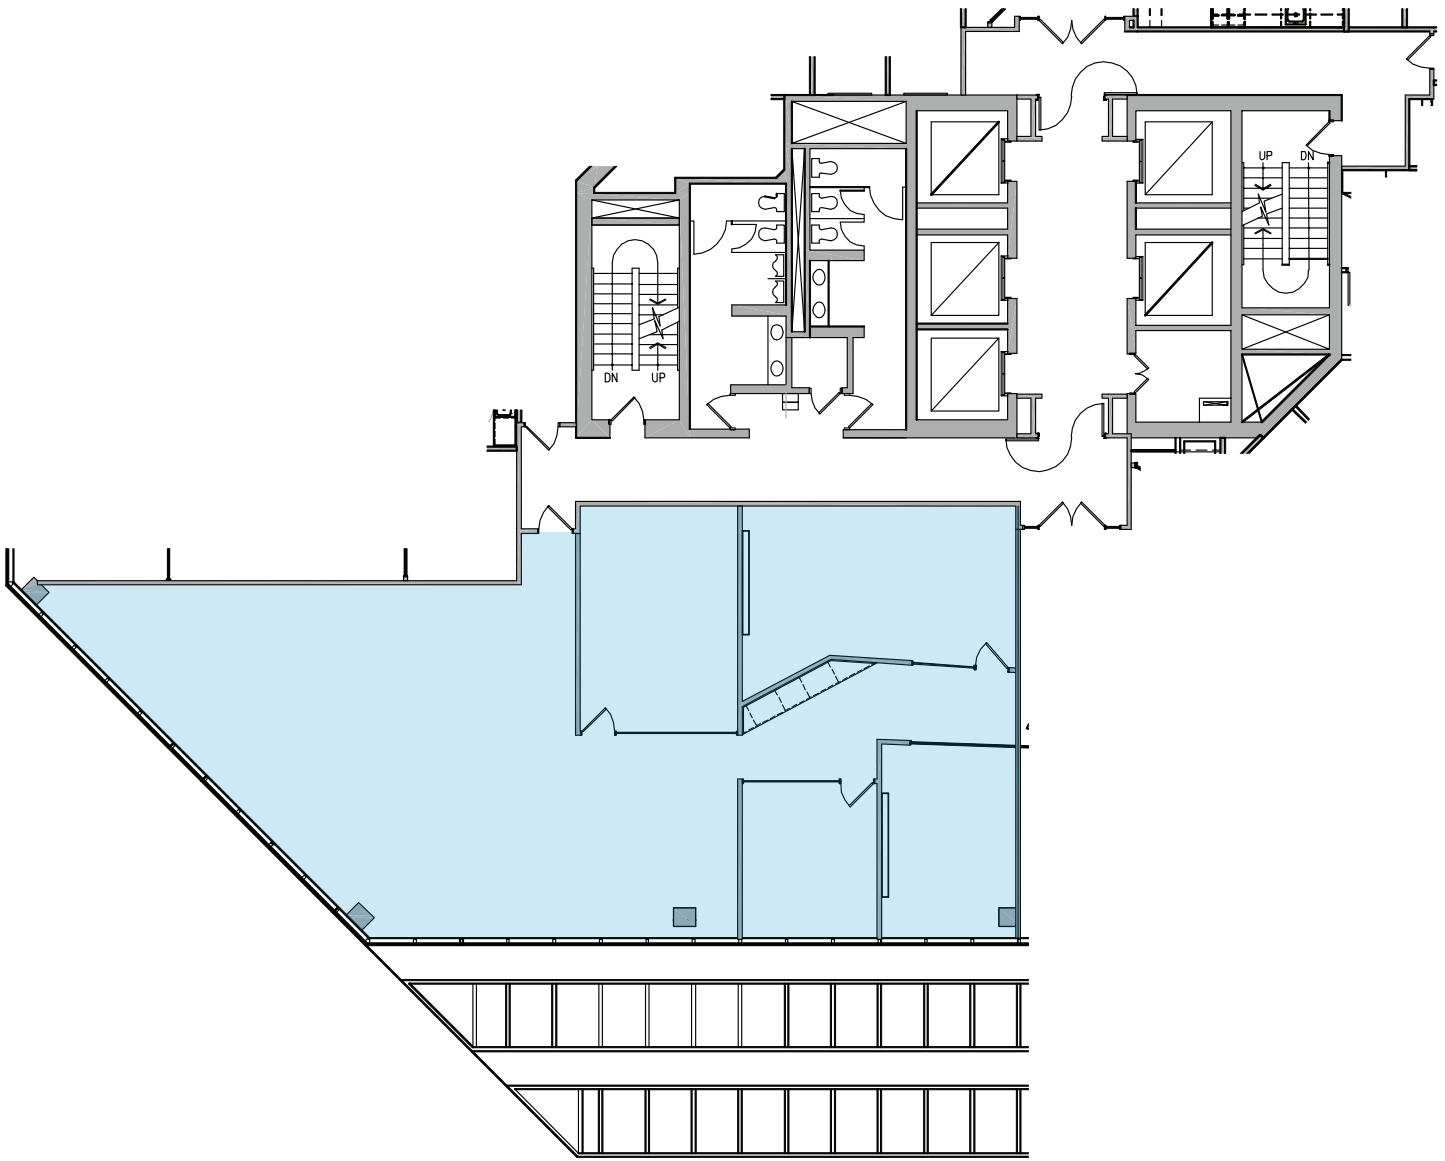


1
725 IC SUITE 725 AS-BUILT - 3,388 RSF
SCALE: 1/16" = 1'-0"

PLAN
NORTH



WILDAMERE

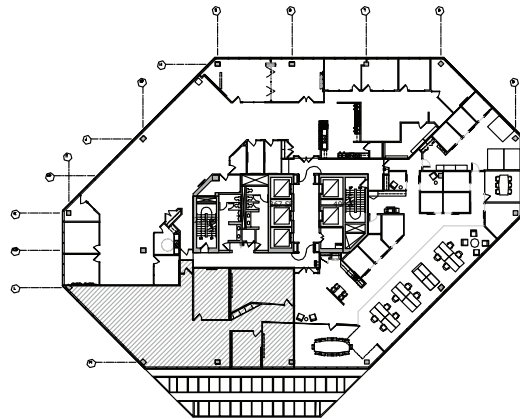

4350 Baker Road ~ Suite 400
Minnetonka, MN 55343
952.897.7874 Fax: 952.897.7740

LOCATION:

INTERNATIONAL CENTRE
FLOOR 7
920 SECOND AVE. SOUTH
MINNEAPOLIS, MN 55410

SCALE:

1/16" = 1'-0"

JOB:

2017.050.0

REVISION:

DATE



SHEET NO.: 1 OF 17

XXX

DRAWN BY: TGW

DATE: 30 JAN. '18

Ste 725