


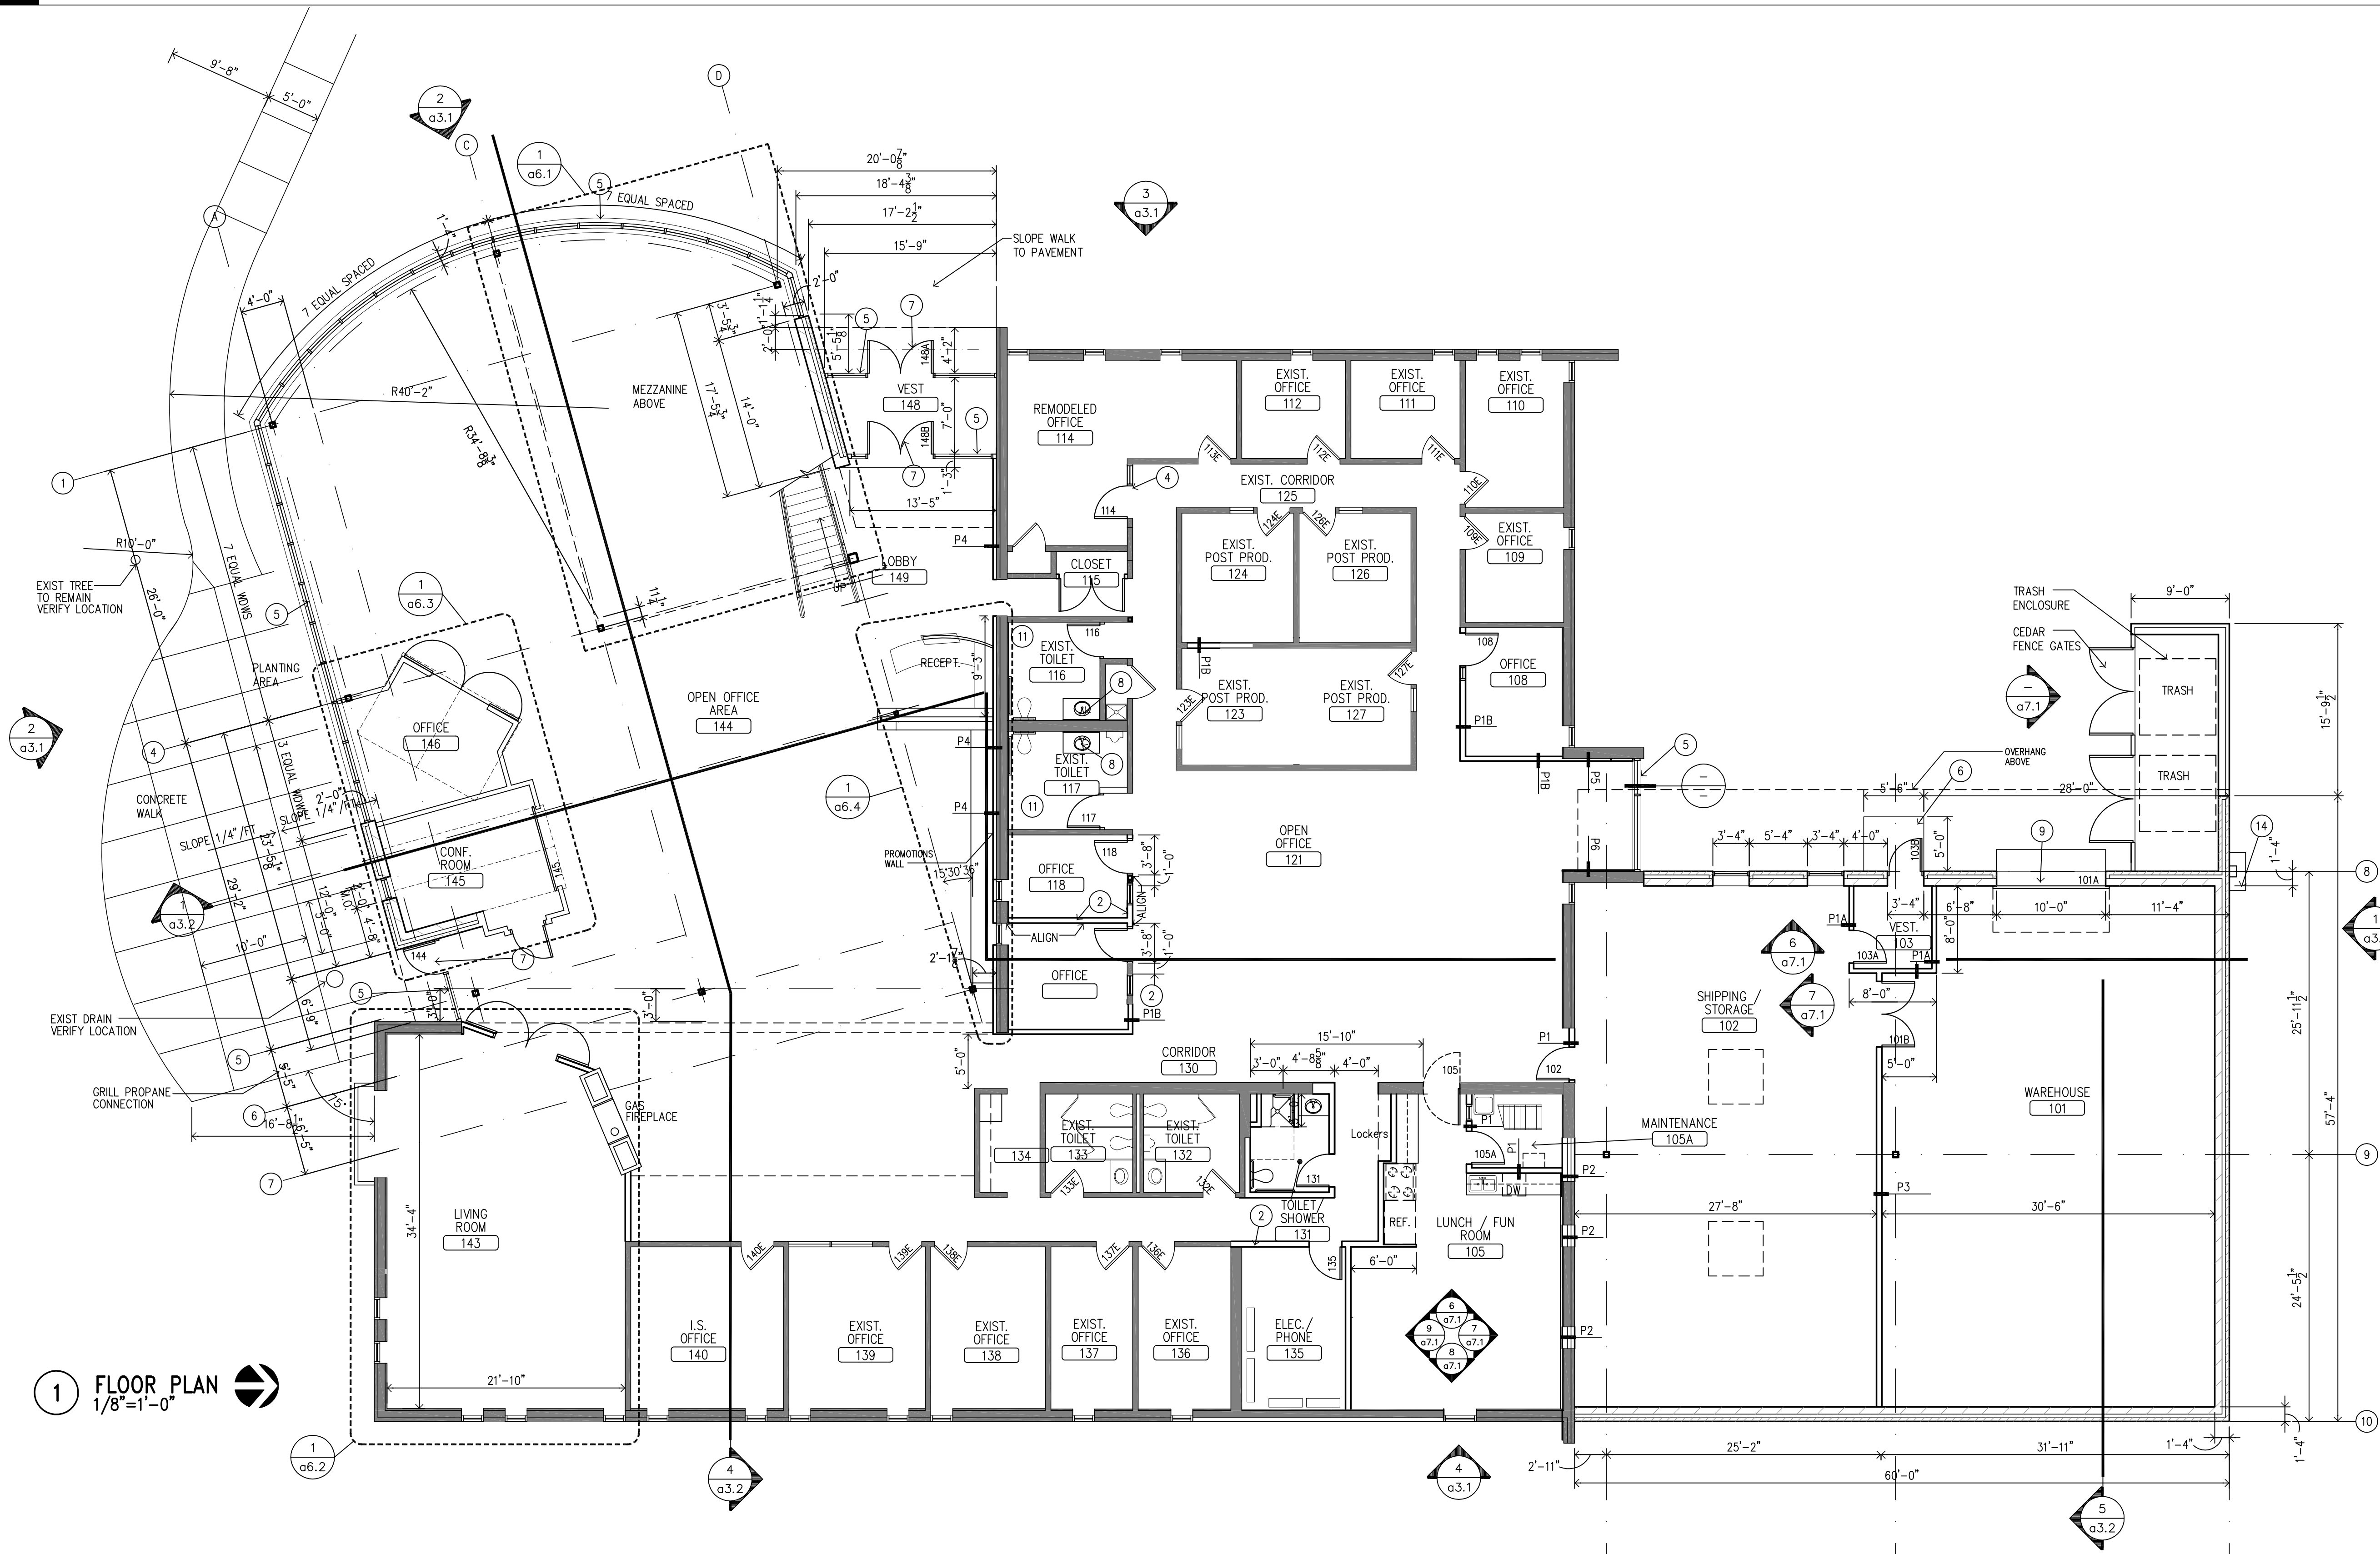

FLOOR PLAN KEY NOTES

- 1 NEW GYP.BD. WALLS TO STRUCT. ABOVE
- 2 NEW GYP.BD. WALLS TO 6\"/>


PARTITION TYPES

- P1 3 5/8\"/>



1 FLOOR PLAN
1/8\"/>

DOOR & OPENING SCHEDULE																			
DOOR NO.	DOOR SIZE (WxH)	DOOR TYPE	FRAME SIZE (WxH)	FRAME TYPE	HARDWARE GROUP	RATING	REMARKS	DETAIL HEAD	JAMB	SILL	118	119	120	121	122	123	124	125	126
101A	10'x10'	O.H.	-	-	1	-	OVERHEAD DOOR, PAINT EXTERIOR												
101B	2 (3'-0\"/>	1	6'-4\"/>	A	2	-	PAINT												
102	3'-0\"/>	1	3'-4\"/>	A	3	-	PAINT												
103A	3'-0\"/>	1	3'-4\"/>	A	4	-	PAINT												
103B	3'-0\"/>	1	3'-4\"/>	A	4	-	EXTERIOR INSULATED, PAINT												
104	NOT USED																		
105																			
105A	3'-0\"/>	2	3'-4\"/>	A	6	-													
108	3'-0\"/>	2	5'-0\"/>	B	5	-													
114	3'-0\"/>	2	5'-0\"/>	B	5	-													
115	2 (3'-0\"/>	2	6'-4\"/>	A															
118	3'-0\"/>	2	5'-0\"/>	B	5	-													
119	2 (3'-0\"/>	2	6'-4\"/>	A	5	-													
120	3'-0\"/>	2	3'-4\"/>	A															
122	NOT USED																		
128	NOT USED																		
129	NOT USED																		
131	3'-0\"/>	2	3'-4\"/>	A	7	-													
135	3'-0\"/>	2	3'-4\"/>	A	6	-													
143	3'-0\"/>	3	3'-4\"/>	ALUM.	1	-													
144	3'-0\"/>	ALUM.	ALUM.	BY DOOR MFRG.															
145	7'-6\"/>	x	7'-0\"/>	x	x	-													
146	3'-0\"/>	2	5'-0\"/>	B	5	-													
147	NOT USED																		
148A	2 (3'-0\"/>	ALUM.	ALUM.	BY DOOR MFRG.															
148B	2 (3'-0\"/>	ALUM.	ALUM.	BY DOOR MFRG.															

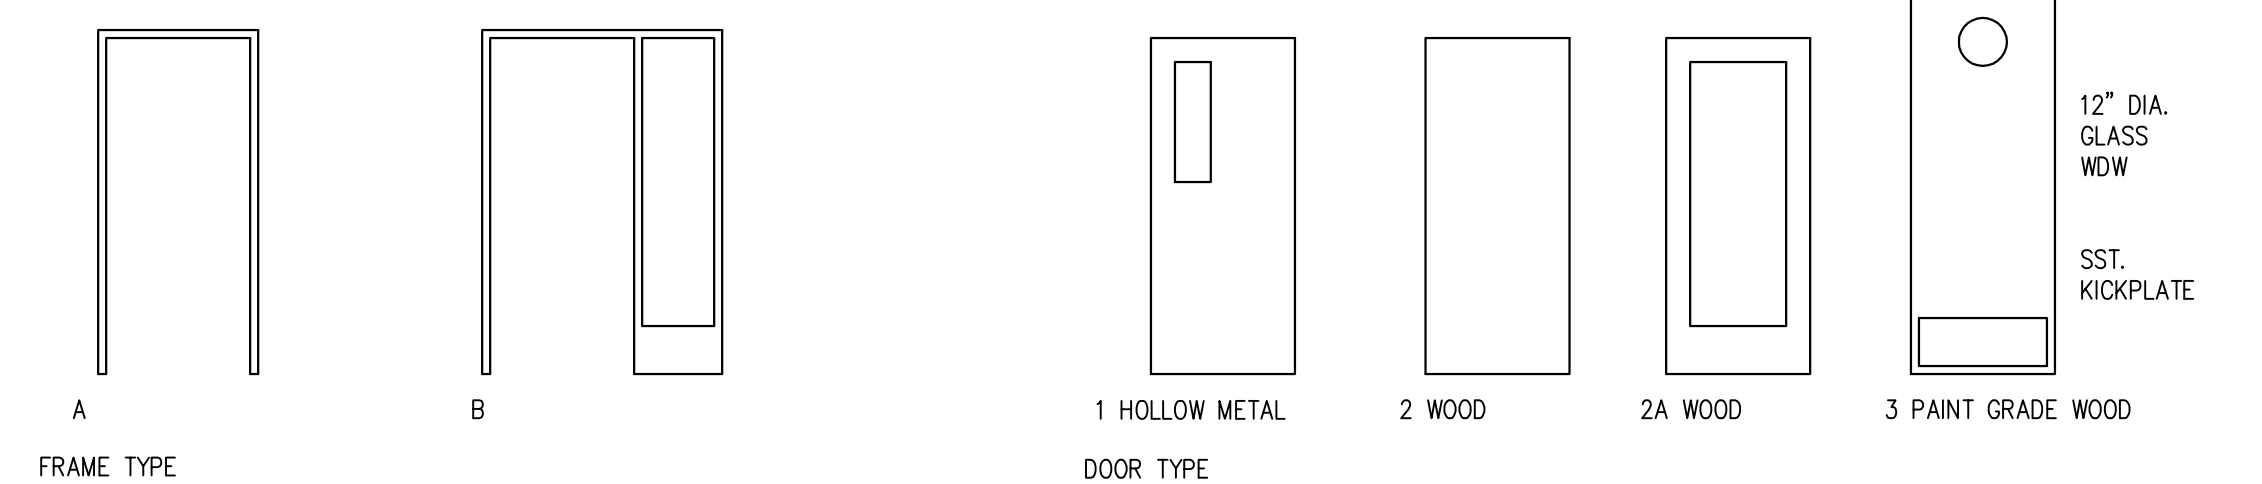

Comm. No.
0174
Date
2/8/02

MBJ
MEYER, BORGMAN AND
JOHNSON, INC.
CONSULTING STRUCTURAL ENGINEERS
12 SOUTH SIXTH STREET SUITE 610
MINNEAPOLIS, MINNESOTA 55402
(612) 338-0713 FAX (612) 337-5325

Issue Dates:
Building Permit Set 2/11/02
Construction Set 4/15/02
Revision #1 5/15/02
Revision #2 5/23/02
As Built Set 2/21/03

Owner
Charthouse Learning
Project
Building Remodel and Expansion
Title
Floor Plan

I hereby certify that this drawing was prepared by me or under my direct supervision and that I am a duly registered architect under the laws of the State of Minnesota.
By
Title Architect Date
Registration Number 16366

Drawing No.

a2.1

HAGEN, CHRISTENSEN & MCILWAIN
ARCHITECTS
212 THIRD AVENUE NO. 5 SUITE 350 • MINNEAPOLIS, MN 55401
TEL (612) 904-1322 • FAX (612) 904-7266