



SUITE 201

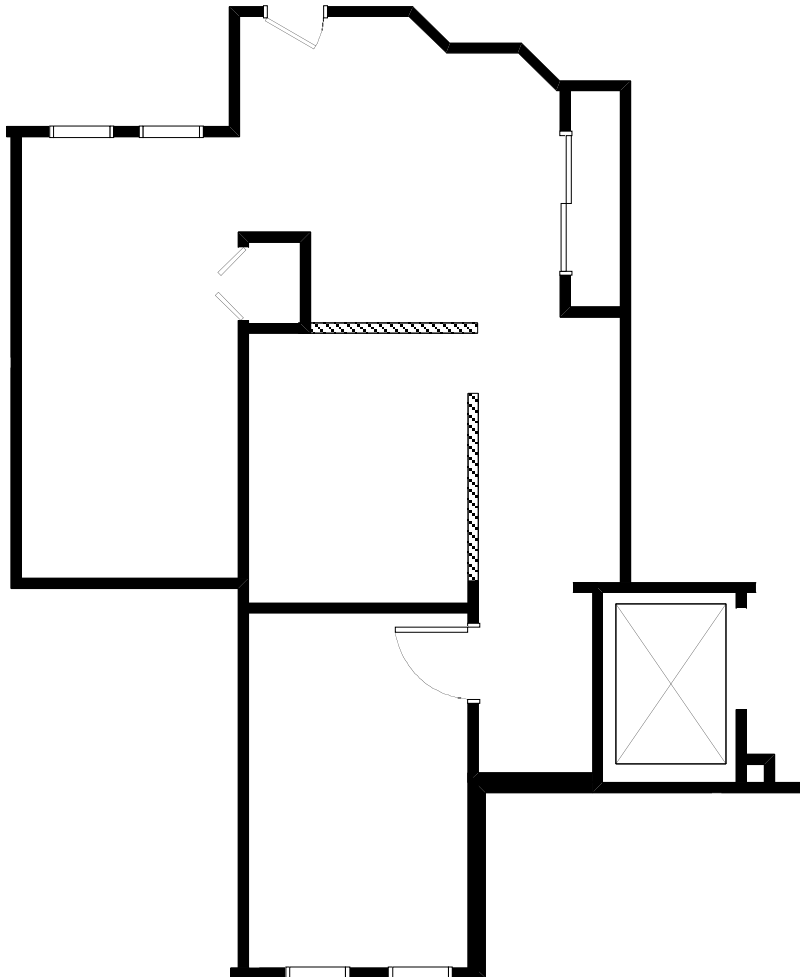


0 5 10 20
SCALE IN FEET

SUITE FLOOR LOCATION

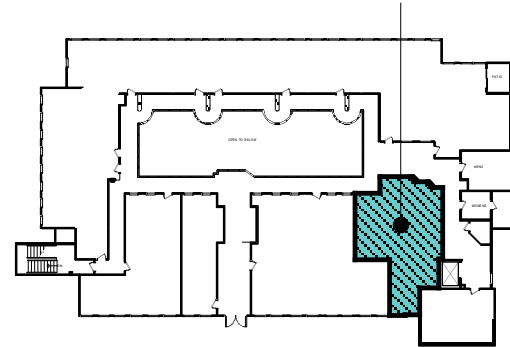

BUILDING 43 - 2ND FLR KEY PLAN

LOCATION
BUILDING 43

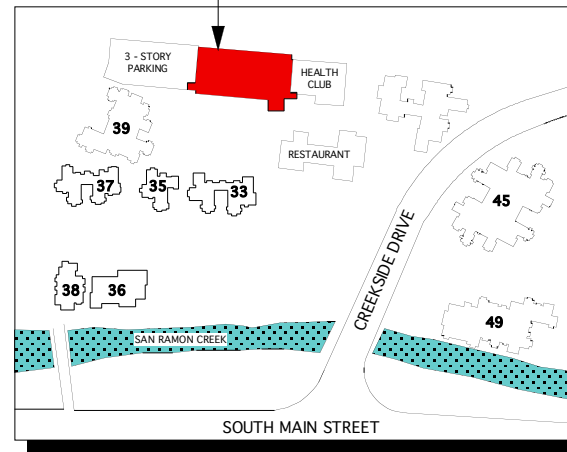

BUILDING KEY PLAN

Leased by



1850 MT. DIABLO BLVD
SUITE 200
WALNUT CREEK, CA
94596

VOICE: (925) 279-0120
FAX: (925) 279-0450

ERIC ERICKSON
(925) 279-5580

QUAIL COURT OFFICE PARK

WALNUT CREEK, CA

Owned and Managed by:

WESTLAKE
DEVELOPMENT
COMPANY, INC.

APPROXIMATE AREA CALCULATIONS
SUBJECT TO VERIFICATION:

865 RSF

AS-BUILT PLAN
TO BE VERIFIED

THIS INFORMATION DISPLAYED WHILE NOT
GUARANTEED HAS BEEN SECURED BY SOURCES WE
BELIEVE TO BE RELIABLE. THIS INFORMATION IS
SUBJECT TO ERRORS & OMISSIONS. ANY TENANT
SHOULD CONDUCT THEIR OWN INVESTIGATION.

PLAN - A 6/11/04