
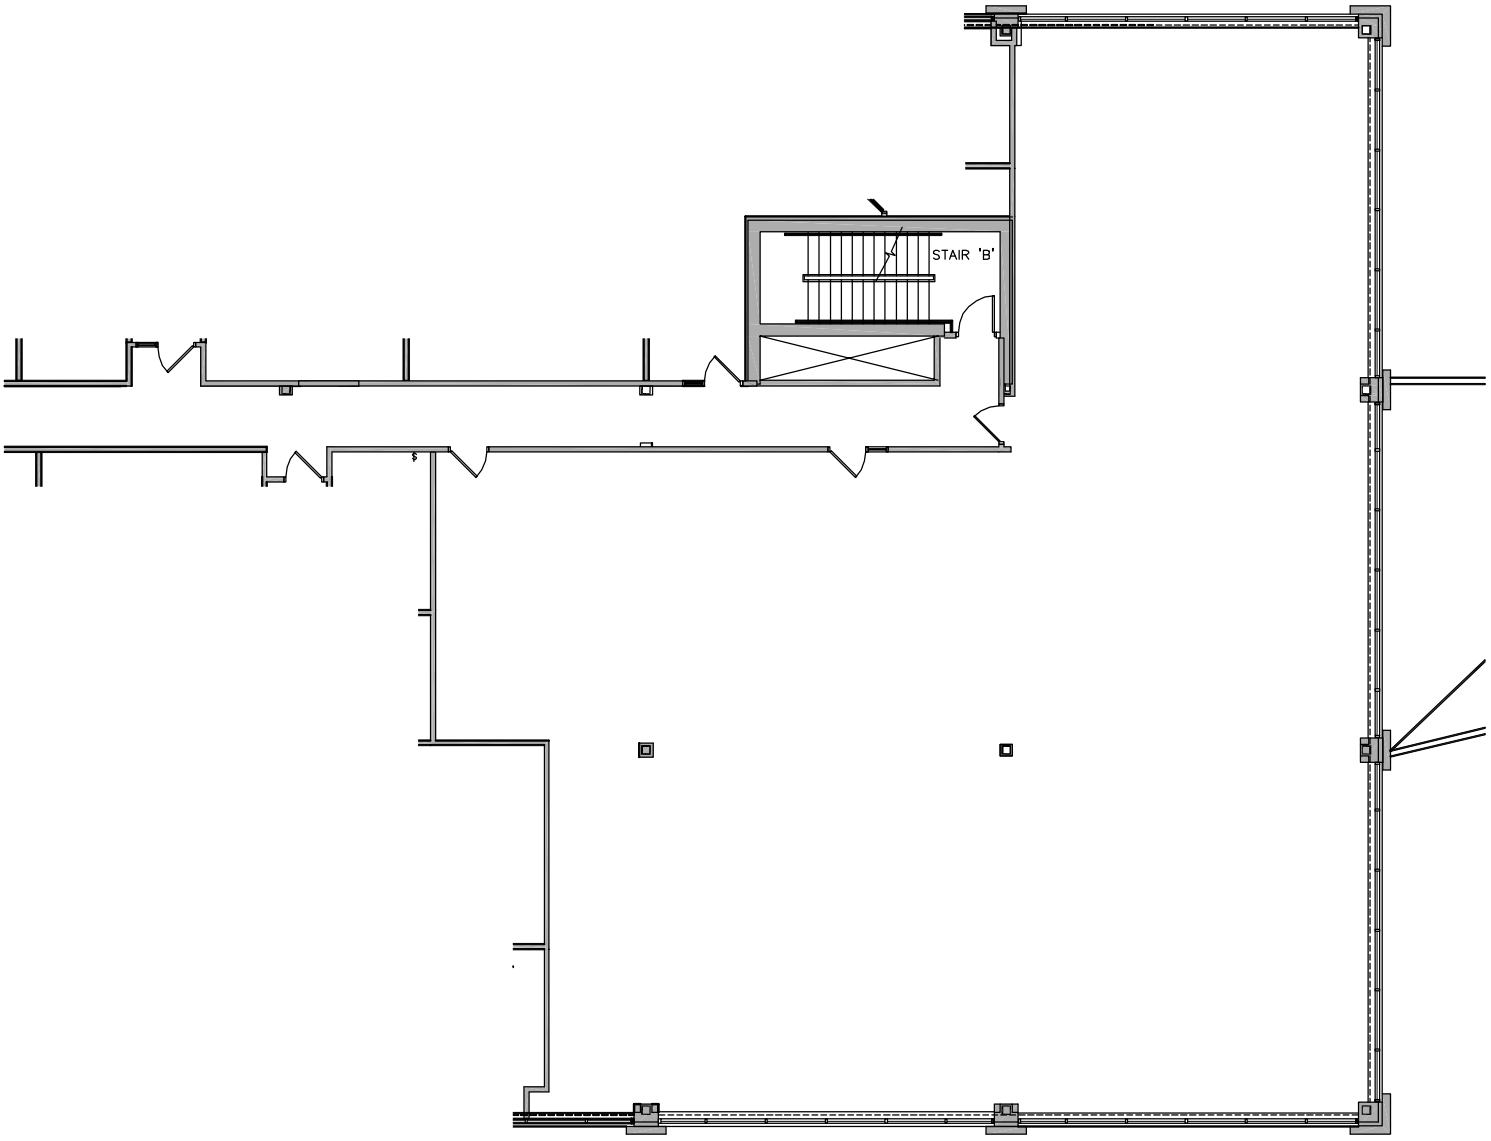


1/220 STE. 220 AS-BUILT
SCALE: 1/16" = 1'-0"

SECOND FLOOR KEY PLAN:

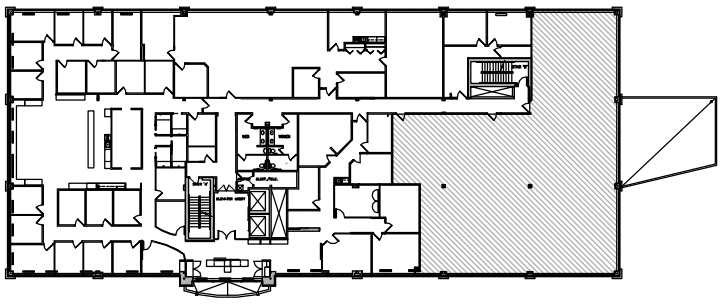

WELSH ARCHITECTURE
4350 Baker Road ~ Suite 400
Minnetonka, MN 55343
952.897.7874 Fax: 952.897.7740

Colliers INTERNATIONAL
LEASING:
Bryan Beltrand:
T (952) 897-7786 F (952) 842-7786

Great Lakes Management Co.
Marketing & Property Management
PROPERTY MANAGEMENT:
Michele Struss:
T (763) 315-9066

SECOND FLOOR PLAN - SUITE 220

Maple Grove Executive Plaza
AREA: 5,955 RSF
7767 ELM CREEK BLVD
MAPLE GROVE, MN 55369

TGW
02 AUG '17

Ste. 220