
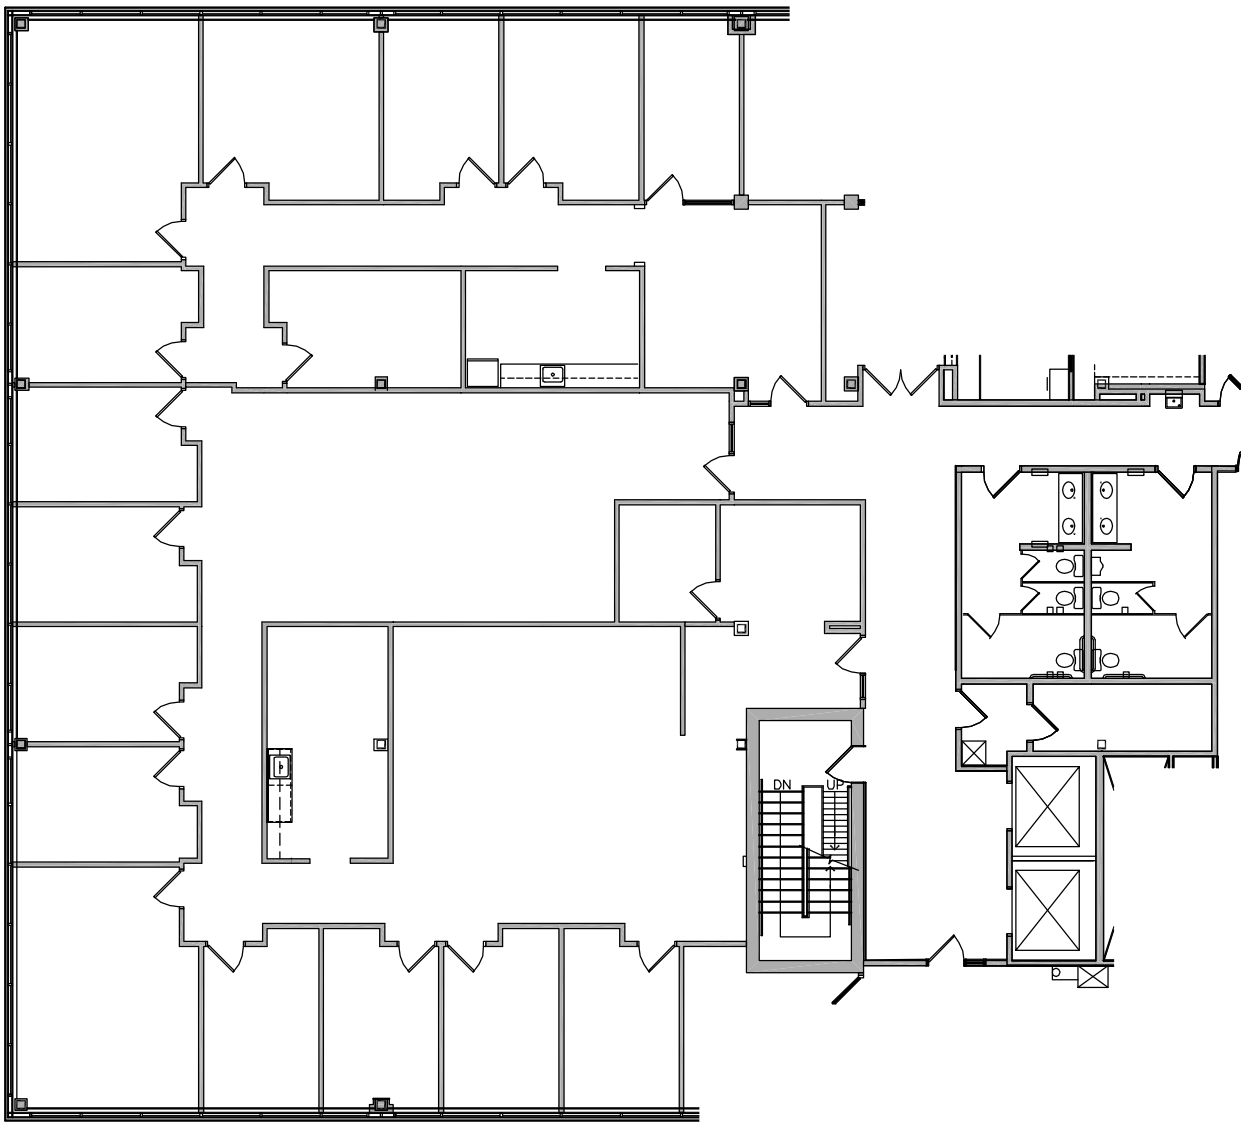


1
305/310

SUITES 305 + 310 AS-BUILT FLOOR PLAN

SCALE: 1/16" = 1'-0"

THIRD FLOOR KEY PLAN:

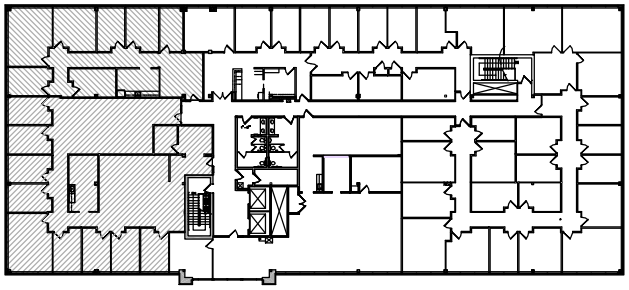

WELSH ARCHITECTURE
4350 Baker Road ~ Suite 400
Minnetonka, MN 55343
952.897.7874 Fax: 952.897.7740

Colliers INTERNATIONAL
LEASING:
Bryan Beltrand:
T (952) 897-7786 F (952) 842-7786

Great Lakes Management Co.
Marketing & Property Management
PROPERTY MANAGEMENT:
Michele Struss:
T (763) 315-9066

THIRD FLOOR - SUITE 305 + 310

Maple Grove Executive Plaza
AREA: 6,562 RSF
7767 ELM CREEK BLVD
MAPLE GROVE, MN 55369

TGW
02 AUG. '17

305/310