
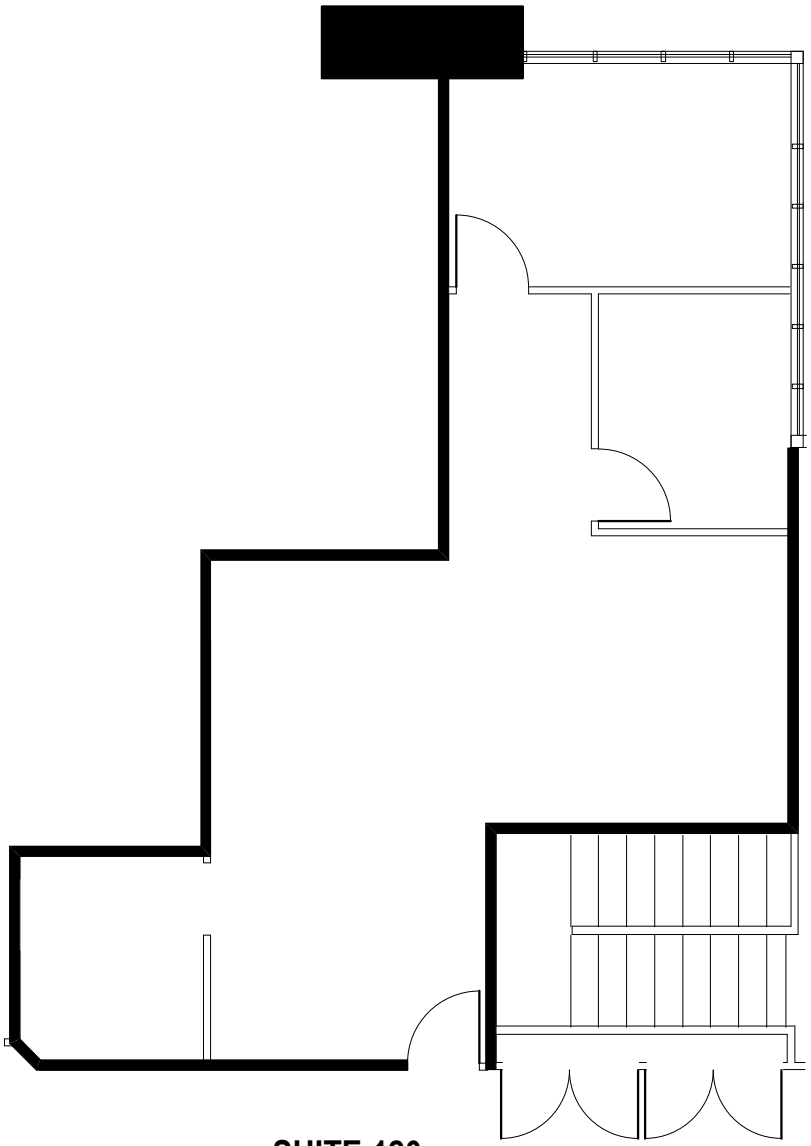


SUITE 120

SUITE FLOOR LOCATION

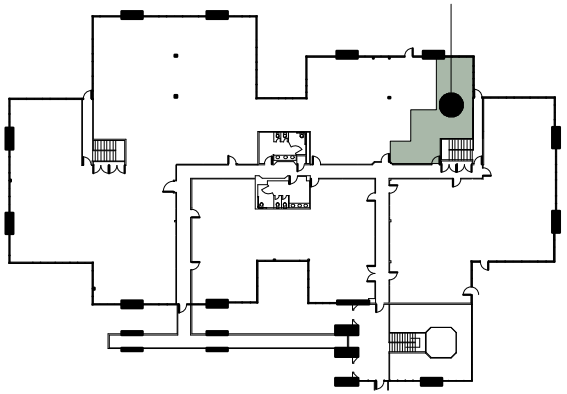

KEY PLAN NORTH BUILDING - FLOOR 1

Colliers International
1850 Mount Diablo Boulevard, Suite 200
Walnut Creek, CA 94596 | United States
www.colliers.com

LEASING AGENT

Matt Hurd
(925) 279-5567

matt.hurd@colliers.com

Scott Ellis
(925) 279-5575

scott.ellis@colliers.com

1600
South Main Plaza
Walnut Creek, CA

First Floor

Managed by:

WCSI
Properties LLC

Approximate Area Calculations
Subject To Verification:

977 rsf

As-built Plan To Be Verified

This information displayed while not guaranteed has been secured by sources we believe to be reliable.
This information is subject to errors & omissions. Any tenant should conduct their own investigation.

Plan Revision - 1-1-18