# Amtrust Blank Plaza

8211 W. Broward Blvd.
Plantation, FL 33324



**3,504 RSF**
SUITE 400

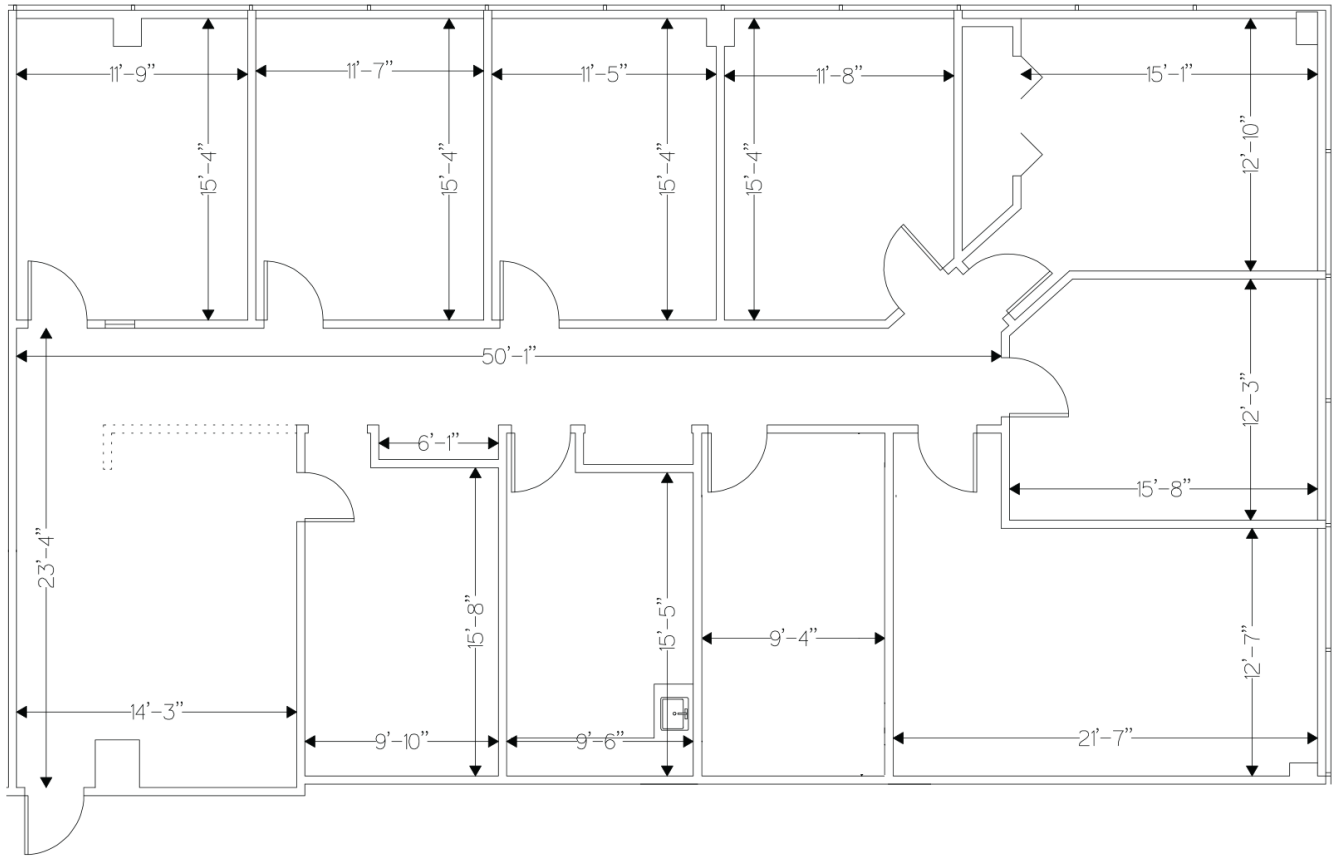

ALFIE HAMILTON
954 453 6050 direct
alfie.hamilton@colliers.com

CAITLIN INKLEBARGER
954 453 6055
caitlin.inklebarger@colliers.com

COLLIERS INTERNATIONAL
SOUTH FLORIDA, LLC
100 NE 3rd Avenue, Suite 780
Fort Lauderdale, FL 33301

tel +1 954 951 2577
fax +1 954 667 7945
www.colliers.com/southflorida


Accelerating success.




AS BUILT PLAN