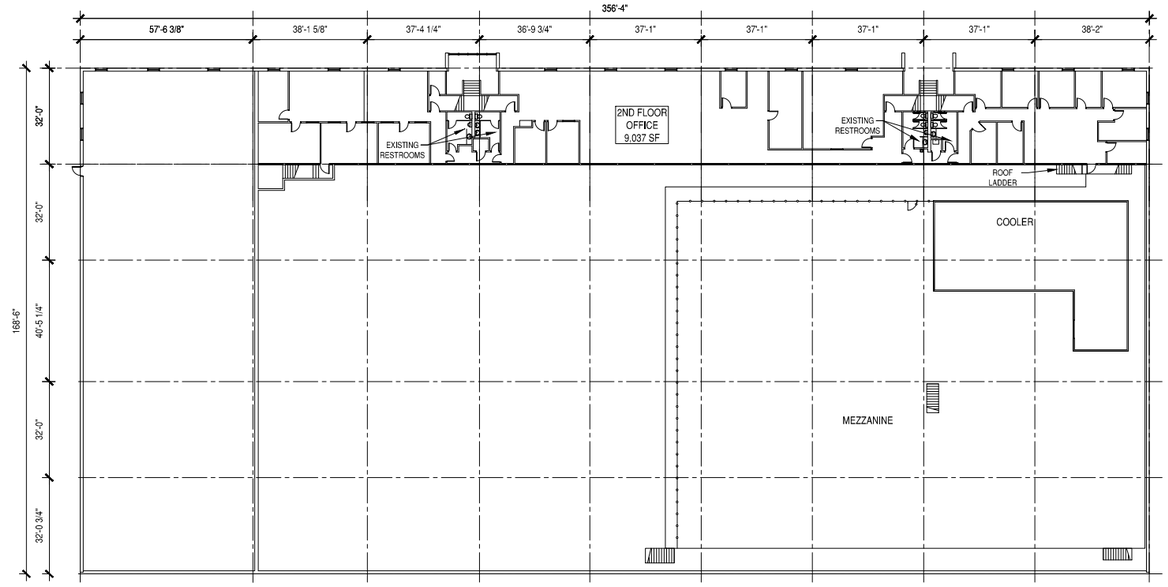

1 / UP-1 2ND FLOOR/MEZZANINE PLAN

SEE GRAPHIC SCALE

GRAPHIC SCALE

0 10' 20' 40'

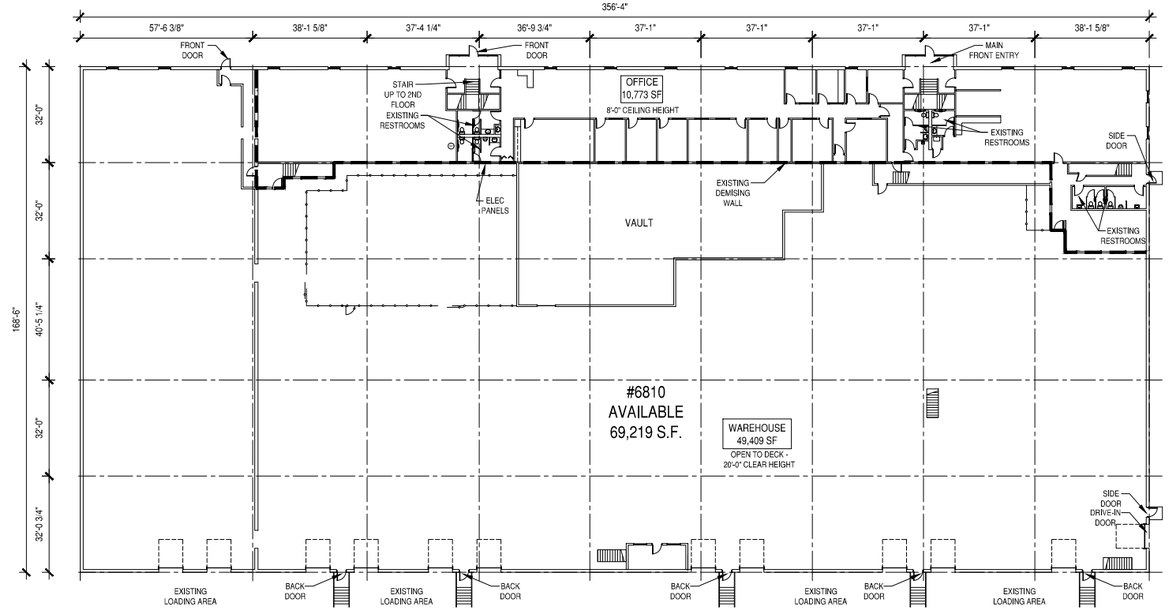

2 / UP-1 FLOOR PLAN

SEE GRAPHIC SCALE

GRAPHIC SCALE

0 10' 20' 40'

NORTH

AS-BUILT UNIT PLAN

UNIT	AS OF	VERSION
6810	6/1/16	UP - 1

TENANT SUMMARY

OFFICE - MAIN	10,773 SF
OFFICE - 2ND FLOOR	9,037 SF
WAREHOUSE	49,409 SF
TOTAL	69,219 SF

DASHED LINE INDICATES OFFICE/ WAREHOUSE SEPARATION

SHADY OAK I - UNIT 6810

PHASE I
6810 SHADY OAK ROAD
EDEN PRAIRIE, MN

DATE: JUNE 1, 2016
DRAWN BY: MATT ROBERTSON

CSM
500 Washington Avenue South, Suite 3000
Minneapolis, MN 55415
Bus: (612) 395-7000 Fax: (612) 395-7002
DEVELOPING REAL ESTATE FOR PEOPLE, BUSINESS & COMMUNITIES

UP-1

G:\Arch 2000\Projects-Active\Shady Oak Crossing\Tenant As-Builts\Unit 6810\Unit 6810.dwg